

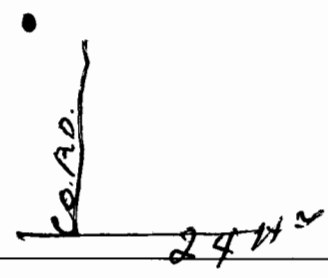
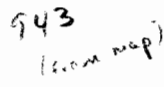
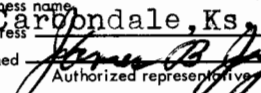
USE TYPEWRITER OR BALL POINT PEN—PRESS FIRMLY, PRINT CLEARLY.

WATER WELL RECORD
KSA 82a-1201-1215

DAD

T R sec 1/4 1/4 1/4 No.

Kansas State Dept. Of Health
(Water Well Contractors)
Forbes-Bldg. 740
Topeka, Kansas 66620

1 Location of well:	County Shawnee	Township name	Fraction SW 1/4 SW 1/4	Section number 1	Town number 11	Range number 14E
Distance and direction from nearest town or city: Street address of well location if in city:			3 Owner of well: William Frey Address: Silver Lake, Ks.			
Locate with "X" in section below: N W E S 1 Mile		Sketch map: 		4 Well depth: 96 ft. Date of completion 5/10/75 Well diameter 6 in.		
2 Type and color of material		From To		5 <input checked="" type="checkbox"/> Cable tool <input type="checkbox"/> Rotary <input type="checkbox"/> Driven <input type="checkbox"/> Dug <input type="checkbox"/> Hollow rod <input type="checkbox"/> Jetted <input type="checkbox"/> Bored <input type="checkbox"/> Reverse rotary		
				6 Use: <input checked="" type="checkbox"/> Domestic <input type="checkbox"/> Public supply <input type="checkbox"/> Industry <input type="checkbox"/> Irrigation <input type="checkbox"/> Air conditioning <input type="checkbox"/> Commercial <input type="checkbox"/> Test well <input type="checkbox"/>		
Red clay		0 12		7 Casing: Material steel Weight: above/below Threaded <input type="checkbox"/> Welded <input checked="" type="checkbox"/> Surface 12 in. Diam. _____ Weight _____ lbs./ft. _____ 6 in. to 56 ft. depth Drive shoe? <input checked="" type="checkbox"/> Yes <input type="checkbox"/> No 5 in. to 96 ft. depth P.V.C.		
Yellow clay		12 46		8 Screen: Manufacturer shop Type PVC Dia. 5" Slot/gauze _____ Length 50 Set between 46 ft. and 96 ft. _____ Fittings: Gravel pack <input type="checkbox"/> Yes <input checked="" type="checkbox"/> No Size range of material _____		
Yellow sandy clay		46 52		9 Static water level: 31 ft. below land surface Date 5/10/75		
Yellow clay sand and gravel		52 54		10 Pumping level below land surfaces: _____ ft. after _____ hrs. pumping _____ g.p.m. _____ ft. after _____ hrs. pumping _____ g.p.m. Estimated maximum yield 4 g.p.m.		
Sandstone brown		54 62		11 Water sample submitted: <input type="checkbox"/> Yes <input checked="" type="checkbox"/> No Date _____		
Sandstone gray		62 96		12 Well head completion: 12" <input type="checkbox"/> Pitless adapter <input checked="" type="checkbox"/> Inches above grade		
Owner to run slab 4' x 4' x 4"				13 Well grouted? <input checked="" type="checkbox"/> Yes <input type="checkbox"/> No <input checked="" type="checkbox"/> Neat cement <input type="checkbox"/> Bentonite <input type="checkbox"/> Depth: From 0 ft. to 18 ft.		
				14 Nearest source of possible contamination: ft. _____ Direction _____ Type _____ Well disinfected upon completion? <input checked="" type="checkbox"/> Yes <input type="checkbox"/> No		
				15 Pump: <input checked="" type="checkbox"/> Not installed Manufacturer's name _____ Model number _____ HP _____ Volts _____ Length of drop pipe _____ ft. capacity _____ g.m.p. Type: <input type="checkbox"/> Submersible <input type="checkbox"/> Turbine <input type="checkbox"/> Jet <input type="checkbox"/> Reciprocating <input type="checkbox"/> Centrifugal <input type="checkbox"/> Other		
16 Remarks: elevation 				17 Water well contractor's certification: This well was drilled under my jurisdiction and this report is true to the best of my knowledge and belief. Jungmann Bros. Drilling Co. Business name _____ License No. 119 Address Carbondale, Ks. Signed  Date 5-10-75 Authorized representative		

Forward the white, blue and pink copies to the Kansas State Dept. Of Health.

Form WWC-5

BR = 886 ∇ = 909