285 KGS #

USE TYPEWRITER OR BALL POINT PEN-PRESS FIRMLY, PRINT CLEARLY.

WATER WELL RECORD
KSA 82a-1201-1215

OK.

Kansas Department of Health and Environment-Division of Environment
(Water well Contractors)
Topeka, Kansas 66620

1. Location of well:	County	Fraction	Section number	Township number	Range number
	Shawnee	NW 1/4 NW 1/4 NW 1/4	6	T 11 (S)	R 14 (E) (W)

2. Distance and direction from nearest town or city: 2½ E.
Street address of well location if in city: Rossville, Ks.

3. Owner of well: Bryce Dudney
R.R. or street:
City, state, zip code: Rossville, Kans

4. Locate with "X" in section below:

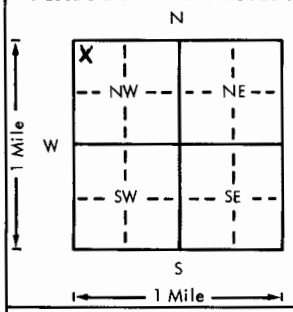

Sketch map:

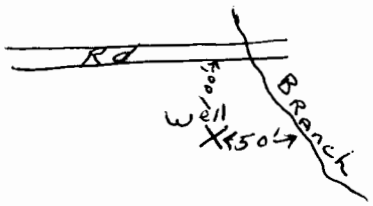

6. Bore hole dia. 10 in. Completion date
Well depth 70 ft. 10-10-77

7. __ Cable tool ✓ Rotary __ Driven __ Dug
__ Hollow rod __ Jetted __ Bored __ Reverse rotary

8. Use: ✓ Domestic __ Public supply __ Industry
__ Irrigation __ Air conditioning __ Stock
__ Lawn __ Oil field water __ Other

9. Casing: Material PVC Height: Above or below
Threaded ___ Welded ___ Surface 24 in.
RMP ___ PVC GL Weight ~~250~~ lbs./ft. 2.74
Dia. 5 in. to 70 ft. depth Wall Thickness: inches or mm .258
Dia. ___ in. to ___ ft. depth gage No. ~~SCH 40~~

5. Type and color of material	From	To
Top Soil	0	4
Sandy Clay	4	18
Grey Shale & Limestone	18	70

(Use a second sheet if needed)

10. Screen: Manufacturer's name Pumpco mfg
Type PVC Dia. 5"
Slot/gauze .020 Length 10'
Set between 13 ft. and 23 ft.
___ ft. and ___ ft.
Gravel pack? ✓ Size range of material .020-.030

11. Static water level: mo./day/yr.
11 ft. below land surface Date 10-10-77

12. Pumping level below land surfaces: Air Test
___ ft. after ___ hrs. pumping ___ g.p.m.
___ ft. after ___ hrs. pumping ___ g.p.m.
Estimated maximum yield 8 g.p.m.

13. Water sample submitted: mo./day/yr.
__ Yes ✓ No Date

14. Well head completion: capped
__ Pitless adapter 24 Inches above grade

15. Well grouted? ✓
With: ✓ Neat cement __ Bentonite __ Concrete
Depth: From 0 ft. to 10 ft.

16. Nearest source of possible contamination: See #19
ft. 50 Direction E Type creek
Well disinfected upon completion? ✓ Yes __ No

17. Pump: ✓ Not installed
Manufacturer's name
Model number HP Volts
Length of drop pipe ft. capacity g.p.m.
Type:
__ Submersible __ Turbine
__ Jet __ Reciprocating
__ Centrifugal __ Other

T 11 R 14 W Sec 6 NW NW NW 1/4 1/4 1/4

18. Elevation: 955
Topography:
__ Hill
✓ Slope
__ Upland
__ Valley

19. Remarks:
Bare lot in pasture-creek only possible contamination @ this time.
Owner to install well slab

20. Water well contractor's certification:
This well was drilled under my jurisdiction and this report is true to the best of my knowledge and belief.
Strader Drlg Co Inc 182
Business name License No.
Address Holton, Ks
Signed Dale Pickerson Date 10/12/77
Authorized representative

Forward the white, blue and pink copies to the Department of Health and Environment

Form WWC-5

MI-1023