

286

OK

LOCATION OF WATER WELL	Fraction <u>SE</u> <u>SE</u> <u>NE</u>	Section Number	Township Number	Range Number
County: <u>Shawnee</u>	<u>NE</u> 1/4 <u>NE</u> 1/4 <u>SE</u> 1/4	<u>6</u>	T <u>11</u> <u>3</u>	R <u>19</u> <u>EW</u>

Distance and direction from nearest town or city? 1 1/2 W OF Silver Lake Street address of well if located within city?

WATER WELL OWNER: Stanley Mitchell
 RR#, St. Address, Box #: RR
 City, State, ZIP Code: Silver Lake, KS. 66539
 Board of Agriculture, Division of Water Resources
 Application Number:

DEPTH OF COMPLETED WELL: 50 ft. Bore Hole Diameter: 8 in. to ft. and in. to ft.

Well Water to be used as:

5 Public water supply	8 Air conditioning	11 Injection well
1 Domestic	3 Feedlot	6 Oil field water supply
2 Irrigation	4 Industrial	7 Lawn and garden only
		10 Observation well
		9 Dewatering
		12 Other (Specify below)

Well's static water level: 30 ft. below land surface measured on SEPT. month 22 day 1980 year

Pump Test Data: Well water was ft. after hours pumping gpm

Est. Yield: 10 gpm: Well water was ft. after hours pumping gpm

TYPE OF BLANK CASING USED:

5 Wrought iron	8 Concrete tile	Casing Joints: Glued <input checked="" type="checkbox"/> Clamped
1 Steel	3 RMP (SR)	6 Asbestos-Cement
2 PVC	4 ABS	9 Other (specify below)
		7 Fiberglass
		11 None used (open hole)

Blank casing dia: 5 in. to 0-40 ft. Dia in. to ft. Dia in. to ft.

Casing height above land surface: 29 in. weight 2.36 lbs./ft. Wall thickness or gauge No. .214

TYPE OF SCREEN OR PERFORATION MATERIAL:

1 Steel	3 Stainless steel	5 Fiberglass	8 RMP (SR)	11 Other (specify)
2 Brass	4 Galvanized steel	6 Concrete tile	9 ABS	12 None used (open hole)

Screen or Perforation Openings Are:

5 Gauzed wrapped	8 Saw cut	11 None (open hole)
1 Continuous slot	3 Mill slot	6 Wire wrapped
2 Louvered shutter	4 Key punched	7 Torch cut
		10 Other (specify)

Screen-Perforation Dia: 5 in. to ft. Dia in. to ft. Dia in. to ft.

Screen-Perforated Intervals: From 40 ft. to 50 ft. From ft. to ft.

Gravel Pack Intervals: From 10 ft. to 50 ft. From ft. to ft.

GROUT MATERIAL: 1 Neat cement 2 Cement grout 3 Bentonite 4 Other

Grouted Intervals: From 0 ft. to 10 ft. From ft. to ft.

What is the nearest source of possible contamination:

1 Septic tank	4 Cess pool	7 Sewage lagoon	11 Fertilizer storage	14 Abandoned water well
2 Sewer lines	5 Seepage pit	8 Feed yard	12 Insecticide storage	15 Oil well/Gas well
3 Lateral lines	6 Pit privy	9 Livestock pens	13 Watertight sewer lines	16 Other (specify below)

Direction from well: N How many feet: 620 ? Water Well Disinfected? Yes No

Was a chemical/bacteriological sample submitted to Department? Yes No If yes, date sample was submitted month day year: Pump Installed? Yes No

Yes: Pump Manufacturer's name: JACUZZI Model No. 554B HP 1/2 Volts 230


Depth of Pump Intake: 45 ft. Pumps Capacity rated at 10 gal./min.

Type of pump: Submersible Turbine Jet Centrifugal Reciprocating Other

CONTRACTOR'S OR LANDOWNER'S CERTIFICATION: This water well was (1) constructed, (2) reconstructed, or (3) plugged under my jurisdiction and was completed on September month 25 day 1980 year

and this record is true to the best of my knowledge and belief. Kansas Water Well Contractor's License No. 182

This Water Well Record was completed on September month 26 day 1980 year under the business name of Strader Drig Co Inc by (signature) Dale Askren

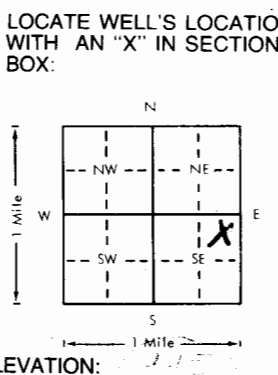

LOCATE WELL'S LOCATION WITH AN "X" IN SECTION BOX:	FROM	TO	LITHOLOGIC LOG	FROM	TO	LITHOLOGIC LOG
	0	6	TOP SOIL			
	6	90	CLAY			
	90	95	FINE SAND, COURSE SAND, GRAVEL			
	95	50	SHALE, GROY			

ELEVATION:

Depth(s) Groundwater Encountered 1. 30 ft. 2. ft. 3. ft. 4. ft. (Use a second sheet if needed)

INSTRUCTIONS: Use typewriter or ball point pen, please press firmly and PRINT clearly. Please fill in blanks, underline or circle the correct answers. Send top three copies to Kansas Department of Health and Environment, Division of Environment, Water Well Contractors, Topeka, KS 66620. Send one to WATER WELL OWNER and retain one for your records.

OFFICE USE ONLY

T

R

14

EW

SEC

NE 1/4

NE 1/4

SE 1/4