

CORRECTION(S) TO WATER WELL RECORD (WWC-5)
(to rectify lacking or incorrect information)

County: SHAWNEE

Location listed as:

Location changed to:

Section-Township-Range: 9-11-14E

Fraction (1/4 1/4 1/4): NW NW

N2 N2 N2 NW

Other changes: Initial statements: owner of well was listed as Jack Clark - he is tenant, not owner.

Changed to: owner name is Berry Family Trust, William Joseph and Karen Sue Trustees, owner address is 4504 W. 83rd St

Comments: Prairie Village KS 66208-5019.

Location of well (for center pivot) is at center of N line of NW 1/4. (Coordinates pulled from google earth & well record in database) sec 9
verification method: Letter and phone conversation with Mr. Bill Berry, owner of well, and landowner on July 27, 2012

initials: WJ date: 7/27/2012
WJL

submitted by: Kansas Geological Survey, Data Resources Library, 1930 Constant Ave., Lawrence, KS 66047-3726
to: Kansas Dept of Health & Environment, Bureau of Water, 1000 SW Jackson, Suite 420, Topeka, KS 66612-1367.


July 20 2012
Prairie Village Kansas

Richard.

Please find enclosed the KGS Water Well Database Query listing Jack Clark as Owner in the Specific Water Well Detail.

We would appreciate your handling for correction of the Database records to reflect **BERRY FAMILY TRUST BERRY WILLIAM JOSEPH & KAREN SUE TRUSTEES** as owner.

We have also enclosed the Real Property Information listing from the Shawnee County Appraiser showing the BERRY FAMILY TRUST as owner of the property location of T11S, R14E, Section 9, NW NW.

Sincerely, 
William J. Karen S. Berry
4504 West 83rd Street
Prairie Village Kansas 66208-5019


RECEIVED
JUL 24 2012
KANSAS GEOLOGICAL SURVEY

1 LOCATION OF WATER WELL: Fraction Near center N.W. 1/4 N.W. 1/4 Section Number 9 Township Number T 11 S Range Number R 14 EW
 County: Shawnee

Distance and direction from nearest town or city street address of well if located within city?
1 mile west of Silver Lake Ks. on U.S. 24 to Valencia Rd. 1 mi. north, and 1/4 mi. east.

2 WATER WELL OWNER: Jack Clark
 RR#, St. Address, Box #: 4144 N.W. Valencia Rd. Board of Agriculture, Division of Water Resources
 City, State, ZIP Code: Silver Lake, Ks. 66539 Application Number: 40,557

3 LOCATE WELL'S LOCATION WITH AN "X" IN SECTION BOX:

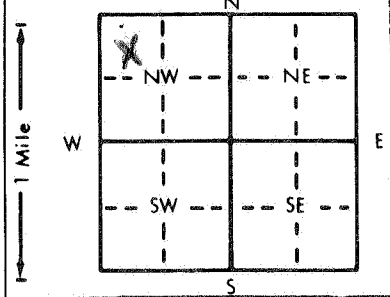

4 DEPTH OF COMPLETED WELL... 51 ft. ELEVATION:
 Depth(s) Groundwater Encountered 1. 17 ft. 2. ft. 3. ft.
 WELL'S STATIC WATER LEVEL 17 ft. below land surface measured on mo/day/yr 12-2-93
 Pump test data: Well water was 37 ft. after 1 hours pumping 700 gpm
 Est. Yield 900 gpm: Well water was 46 ft. after 2 hours pumping 800 gpm
 Bore Hole Diameter... 32 in. to 51 ft., and in. to ft.
 WELL WATER TO BE USED AS: 5 Public water supply 8 Air conditioning 11 Injection well
 1 Domestic 3 Feedlot 6 Oil field water supply 9 Dewatering 12 Other (Specify below)
2 Irrigation 4 Industrial 7 Lawn and garden only 10 Monitoring well
 Was a chemical/bacteriological sample submitted to Department? Yes.....No...XX...; If yes, mo/day/yr sample was submitted
 Water Well Disinfected? Yes No XX

5 TYPE OF BLANK CASING USED: 5 Wrought iron 8 Concrete tile CASING JOINTS: Glued .. XX. Clamped XX ..
 1 Steel 3 RMP (SR) 6 Asbestos-Cement 9 Other (specify below) Welded
2 PVC 4 ABS 7 Fiberglass Threaded
 Blank casing diameter... 16 in. to 31 ft., Dia in. to ft., Dia in. to ft.
 Casing height above land surface... 24 in., weight lbs./ft. Wall thickness or gauge No. 50

TYPE OF SCREEN OR PERFORATION MATERIAL: 7 PVC 10 Asbestos-cement
 1 Steel 3 Stainless steel 5 Fiberglass 8 RMP (SR) 11 Other (specify)
 2 Brass 4 Galvanized steel 6 Concrete tile 9 ABS 12 None used (open hole)
 SCREEN OR PERFORATION OPENINGS ARE: 5 Gauzed wrapped 8 Saw cut 11 None (open hole)
 1 Continuous slot 3 Mill slot 6 Wire wrapped 9 Drilled holes
 2 Louvered shutter 4 Key punched 7 Torch cut 10 Other (specify)
 SCREEN-PERFORATED INTERVALS: From... 31 ft. to 51 ft., From ft. to ft.
 From ft. to ft., From ft. to ft.
 GRAVEL PACK INTERVALS: From... 17 ft. to 51 ft., From ft. to ft.
 From ft. to ft., From ft. to ft.

6 GROUT MATERIAL: 1 Neat cement 2 Cement grout 3 Bentonite 4 Other
 Grout Intervals: From... 0 ft. to 17 ft., From ft. to ft., From ft. to ft.
 What is the nearest source of possible contamination:
 1 Septic tank 4 Lateral lines 7 Pit privy 10 Livestock pens 14 Abandoned water well
 2 Sewer lines 5 Cess pool 8 Sewage lagoon 11 Fuel storage 15 Oil well/Gas well
 3 Watertight sewer lines 6 Seepage pit 9 Feedyard 12 Fertilizer storage 16 Other (specify below)
 13 Insecticide storage none
 Direction from well? How many feet?

FROM	TO	LITHOLOGIC LOG	FROM	TO	PLUGGING INTERVALS
0	5	Heavy black topsoil			
5	21	Brown and grey clays			
21	23	Fine brown sand and brown clay			
23	28	Medium brown gravel			
28	37	Medium-large brown gravel			
37	38	Large brown gravel			
38	42	Large grey gravel and grey clay			
42	47	Medium-large brown gravel			
47	50	Small-medium brown gravel			
50	51	Weathered shale, stopped			

7 CONTRACTOR'S OR LANDOWNER'S CERTIFICATION: This water well was (1) constructed, (2) reconstructed, or (3) plugged under my jurisdiction and was completed on (mo/day/year) 12-2-93 and this record is true to the best of my knowledge and belief. Kansas Water Well Contractor's License No. 323 This Water Well Record was completed on (mo/day/yr) 12-9-93 under the business name of Hoobler Drilling Co. by (signature) Clay Hoobler