WATER WELL RECORD Form WWC-5 KSA 82a-1212 Plugging Report

1 LOCATION OF WATER WELL: Fraction: NW ¼ SW ¼ SE ¼ | Section Number: 15 | Township Number: T 11 S | Range Number: R 14 E/W

County: Shawnee

Distance and direction from nearest town or city street address of well if located within city?
Approx. 1050' N and 2550' W of the SE corner of SEC 15

2 WATER WELL OWNER: Sam G. Kelsey
RR#, St. Address, Box # : 502 Mercury
City, State, ZIP Code : SilverLake, KS 66539

VR SN005,8314
Board of Agriculture, Division of Water Resources
Application Number:

3 LOCATE WELL'S LOCATION WITH AN "X" IN SECTION BOX:

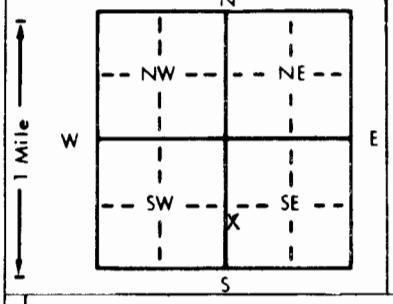


4 DEPTH OF COMPLETED WELL 75 ft. ELEVATION:
Depth(s) Groundwater Encountered 1. ft. 2. ft. 3. ft.
WELL'S STATIC WATER LEVEL 25 ft. below land surface measured on mo/day/yr 5/1/90
Pump test data: Well water was ft. after hours pumping gpm
Est. Yield gpm: Well water was ft. after hours pumping gpm
Bore Hole Diameter in. to ft., and in. to ft.
WELL WATER ~~TO BE~~ USED AS: 5 Public water supply 8 Air conditioning 11 Injection well
1 Domestic was 3 Feedlot 6 Oil field water supply 9 Dewatering 12 Other (Specify below)
*2 Irrigation 4 Industrial 7 Lawn and garden only 10 Monitoring well
Was a chemical/bacteriological sample submitted to Department? Yes No; If yes, mo/day/yr sample was submitted
Water Well Disinfected? Yes No

5 TYPE OF BLANK CASING USED: 5 Wrought iron 8 Concrete tile CASING JOINTS: Glued Clamped
*1 Steel 3 RMP (SR) 6 Asbestos-Cement *9 Other (specify below) Welded
2 PVC 4 ABS 7 Fiberglass brick Threaded
Blank casing diameter 96 in. to 25 (brick) Dia 24 in. to 75 (steel) in. to ft.
Casing height above land surface 6 ft below, weight lbs./ft. Wall thickness or gauge No.

TYPE OF SCREEN OR PERFORATION MATERIAL: 7 PVC 10 Asbestos-cement
1 Steel 3 Stainless steel 5 Fiberglass 8 RMP (SR) 11 Other (specify)
2 Brass 4 Galvanized steel 6 Concrete tile 9 ABS 12 None used (open hole)

SCREEN OR PERFORATION OPENINGS ARE: 5 Gauzed wrapped 8 Saw cut 11 None (open hole)
1 Continuous slot 3 Mill slot 6 Wire wrapped 9 Drilled holes
2 Louvered shutter 4 Key punched 7 Torch cut 10 Other (specify)

SCREEN-PERFORATED INTERVALS: From ft. to ft., From ft. to ft.
From ft. to ft., From ft. to ft.
GRAVEL PACK INTERVALS: From ft. to ft., From ft. to ft.
From ft. to ft., From ft. to ft.

6 GROUT MATERIAL: 1 Neat cement *2 Cement grout 3 Bentonite 4 Other
Grout Intervals: From 6 ft. to 5 ft., From ft. to ft., From ft. to ft.

What is the nearest source of possible contamination:
1 Septic tank 4 Lateral lines 7 Pit privy 10 Livestock pens 14 Abandoned water well
2 Sewer lines 5 Cess pool 8 Sewage lagoon 11 Fuel storage 15 Oil well/Gas well
3 Watertight sewer lines 6 Seepage pit 9 Feedyard 12 Fertilizer storage *16 Other (specify below)
13 Insecticide storage Ag farm land
Direction from well? surrounding well How many feet?

| FROM | TO | LITHOLOGIC LOG | FROM | TO | PLUGGING INTERVALS |
|---|---|---|---|---|---|
| 75 | 25 | Sand + Gravel (157 cubic ft) | | | |
| 25 | 6 | Clay (955 cubic ft) | | | |
| 6 | 5 | Cement Grout (63.6 cubic ft) | | | |
| 5 | 0 | Soil (318 cubic ft) | | | |

7 CONTRACTOR'S OR LANDOWNER'S CERTIFICATION: This water well was (1) constructed, (2) reconstructed, or (3) *plugged under my jurisdiction and was completed on (mo/day/year) 7/1/90 and this record is true to the best of my knowledge and belief. Kansas Water Well Contractor's License No. ----- This Water Well Record was completed on (mo/day/yr) 8/29/90
under the business name of ----- by (signature) Sam G Kelsey

INSTRUCTIONS: Use typewriter or ball point pen. *PLEASE PRESS FIRMLY* and *PRINT* clearly. Please fill in blanks, underline or circle the correct answers. Send top three copies to Kansas Department of Health and Environment, Bureau of Water, Topeka, Kansas 66620-7320. Telephone: 913-296-5545. Send one to WATER WELL OWNER and retain one for your records.