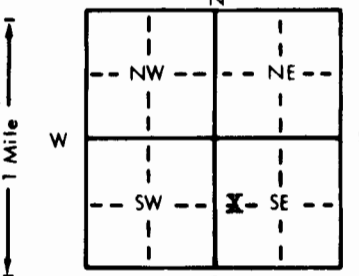


1 LOCATION OF WATER WELL:		Fraction	CENTER OF WEST SIDE	SE	1/4	1/4	1/4	Section Number	16	Township Number	T 11 S	Range Number	R 14 E
County: Shawnee													
Distance and direction from nearest town or city street address of well if located within city? 3/4 mi. S & 1/4 mi. S edge of Silver Lake													
2 WATER WELL OWNER: Mrs. Colleen Dougan													
RR#, St. Address, Box # : 2801 Plass Avenue													
City, State, ZIP Code : Topeka, KS 66611													
Board of Agriculture, Division of Water Resources													
Application Number: 34,848													
3 LOCATE WELL'S LOCATION WITH AN "X" IN SECTION BOX:		4 DEPTH OF COMPLETED WELL: 70 ft. ELEVATION: 17 ft.											
		Depth(s) Groundwater Encountered 1. 17 ft. 2. ft. 3. ft.											
		WELL'S STATIC WATER LEVEL 17 ft. below land surface measured on mo/day/yr 12-12-84											
		Pump test data: Well water was 28 ft. after 1 hours pumping 1000 gpm											
		Est. Yield 1500 gpm: Well water was 32 ft. after 2 hours pumping 1000 gpm											
		Bore Hole Diameter 32 in. to 70 ft., and in. to ft.											
		WELL WATER TO BE USED AS: 5 Public water supply 8 Air conditioning 11 Injection well											
		1 Domestic 3 Feedlot 6 Oil field water supply 9 Dewatering 12 Other (Specify below)											
		2 Irrigation 4 Industrial 7 Lawn and garden only 10 Observation well											
		Was a chemical/bacteriological sample submitted to Department? Yes No X; If yes, mo/day/yr sample was submitted											
		Water Well Disinfected? Yes No X											
5 TYPE OF BLANK CASING USED:													
1 Steel 3 RMP (SR) 5 Wrought iron 8 Concrete tile CASING JOINTS: Glued Clamped X													
2 PVC 4 ABS 6 Asbestos-Cement 9 Other (specify below) Welded													
7 Fiberglass Threaded													
Blank casing diameter 16 in. to 31 ft., Dia in. to ft., Dia in. to ft.													
Casing height above land surface 12 in., weight lbs./ft. Wall thickness or gauge No. 750													
TYPE OF SCREEN OR PERFORATION MATERIAL:													
1 Steel 3 Stainless steel 5 Fiberglass 7 PVC 10 Asbestos-cement													
2 Brass 4 Galvanized steel 6 Concrete tile 8 RMP (SR) 11 Other (specify)													
9 ABS 12 None used (open hole)													
SCREEN OR PERFORATION OPENINGS ARE:													
1 Continuous slot 3 Mill slot 5 Gauzed wrapped 8 Saw cut 11 None (open hole)													
2 Louvered shutter 4 Key punched 6 Wire wrapped 9 Drilled holes													
7 Torch cut 10 Other (specify)													
SCREEN-PERFORATED INTERVALS: From 31 ft. to 39 ft., From ft. to ft.													
From ft. to ft., From ft. to ft.													
GRAVEL PACK INTERVALS: From 10 ft. to 40 ft., From ft. to ft.													
From ft. to ft., From ft. to ft.													
6 GROUT MATERIAL: 1 Neat cement 2 Cement grout 3 Bentonite 4 Other													
Grout Intervals: From 0 ft. to 10 ft., From ft. to ft., From ft. to ft.													
What is the nearest source of possible contamination:													
1 Septic tank 4 Lateral lines 7 Pit privy 10 Livestock pens 14 Abandoned water well													
2 Sewer lines 5 Cess pool 8 Sewage lagoon 11 Fuel storage 15 Oil well/Gas well													
3 Watertight sewer lines 6 Seepage pit 9 Feedyard 12 Fertilizer storage 16 Other (specify below)													
13 Insecticide storage 14 Creek Channel													
Direction from well? NW How many feet? 120 ft.													
FROM TO LITHOLOGIC LOG FROM TO LITHOLOGIC LOG													
0 2 heavy black silt													
2 17 gray sandy silt													
17 28 small brown sand													
28 41 medium gray gravel													
41 70 medium - large brown gravel													
70 large rocks STOPPED													
7 CONTRACTOR'S OR LANDOWNER'S CERTIFICATION: This water well was (1) constructed, (2) reconstructed, or (3) plugged under my jurisdiction and was completed on (mo/day/year) 12-10-84 and this record is true to the best of my knowledge and belief. Kansas													
Water Well Contractor's License No. 323 This Water Well Record was completed on (mo/day/yr) 12-20-84													
under the business name of Hoobler Drilling Company by (signature) [Signature]													
INSTRUCTIONS: Use typewriter or ball point pen, PLEASE PRESS FIRMLY and PRINT clearly. Please fill in blanks, underline or circle the correct answers. Send top three copies to Kansas Department of Health and Environment, Division of Environment, Environmental Geology Section, Topeka, KS 66620. Send one to WATER WELL OWNER and retain one for your records.													