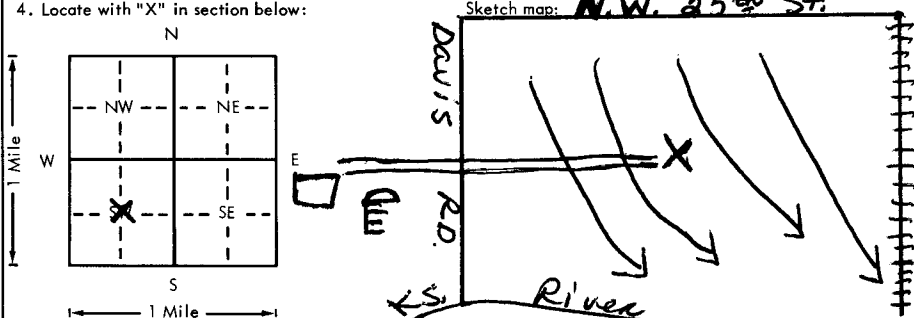


199 ✓

USE TYPEWRITER OR BALL
POINT PEN-PRESS FIRMLY,
PRINT CLEARLY.

WATER WELL RECORD
KSA 82a-1201-1215

Kansas Department of Health and
Environment-Division of Environment
(Water well Contractors)
Topeka, Kansas 66620

1. Location of well:		County Shawnee	Fraction Ctr. of --- SW 1/4	Section number 18	Township number T 11 S	Range number R 14 E	E/W E/W
2. Distance and direction from nearest town or city: 2 1/2 mi. West of Rossville, Ks. on U.S. 24 & 1 3/4 mi. South on Davis Road.				3. Owner of well: Marjorie H. Crane R.R. or street: 1320 W. 27th St.-Apt. C41 City, state, zip code: Topeka, Ks.			
4. Locate with "X" in section below: 				6. Bore hole dia. 30 in. Completion date 3-30-77 Well depth 74 ft.			
5. Type and color of material				From	To		
7. <input type="checkbox"/> Cable tool <input type="checkbox"/> Rotary <input type="checkbox"/> Driven <input type="checkbox"/> Dug <input type="checkbox"/> Hollow rod <input type="checkbox"/> Jetted <input type="checkbox"/> Bored <input checked="" type="checkbox"/> Reverse rotary				8. Use: <input type="checkbox"/> Domestic <input type="checkbox"/> Public supply <input type="checkbox"/> Industry <input checked="" type="checkbox"/> Irrigation <input type="checkbox"/> Air conditioning <input type="checkbox"/> Stock <input type="checkbox"/> Lawn <input type="checkbox"/> Oil field water <input type="checkbox"/> Other			
9. Casing: Material Transite Height (Above or below) Threaded <input type="checkbox"/> Welded <input type="checkbox"/> Surface 12 in. RMP <input type="checkbox"/> PVC <input type="checkbox"/> Weight <input type="checkbox"/> lbs./ft. Dia. 16 in. to 35 ft. depth Wall Thickness: inches or Dia. <input type="checkbox"/> in. to <input type="checkbox"/> ft. depth gage No. 75				10. Screen: Manufacturer's name Johnson Well Co. Type Transite Dia. 16 " Slot/gauze 1/8 x 8 Length 39' Set between 35 ft. and 74 ft. Gravel pack? yes Size range of material 1/8-1/4"			
11. Static water level: 17 ft. below land surface Date 3-15-77				12. Pumping level below land surfaces: 24 ft. after 1 hrs. pumping 1000 g.p.m. 30' ft. after 3 hrs. pumping 1500 g.p.m. Estimated maximum yield 2000 g.p.m.			
13. Water sample submitted: <input type="checkbox"/> Yes <input checked="" type="checkbox"/> No Date				14. Well head completion: <input type="checkbox"/> Pitless adapter <input type="checkbox"/> Inches above grade			
15. Well grouted? yes With: <input type="checkbox"/> Neat cement <input type="checkbox"/> Bentonite <input checked="" type="checkbox"/> Concrete Depth: From 0 ft. to 10 ft.				16. Nearest source of possible contamination: ft. 1700 Direction west Type septic tank Well disinfected upon completion? <input type="checkbox"/> Yes <input checked="" type="checkbox"/> No			
17. Pump: <input checked="" type="checkbox"/> Not installed Manufacturer's name Model number <input type="checkbox"/> HP <input type="checkbox"/> Volts Length of drop pipe <input type="checkbox"/> ft. capacity <input type="checkbox"/> g.p.m. Type: <input type="checkbox"/> Submersible <input type="checkbox"/> Turbine <input type="checkbox"/> Jet <input type="checkbox"/> Reciprocating <input type="checkbox"/> Centrifugal <input type="checkbox"/> Other				20. Water well contractor's certification: This well was drilled under my jurisdiction and this report is true to the best of my knowledge and belief. Hoobler Drilling Co. 323 Business name License No. Address St. Marys, Ks. 66536 Signed Don Hoobler Date 4-5-77 Authorized representative			
18. Elevation: 910 pm Topography: <input type="checkbox"/> Hill <input type="checkbox"/> Slope <input type="checkbox"/> Upland <input checked="" type="checkbox"/> Valley		19. Remarks: We do not install pumps.					

Forward the white, blue and pink copies to the Department of Health and Environment

Form WWC-5