


1 LOCATION OF WATER WELL: Fraction Center $\frac{1}{4}$ of NE $\frac{1}{4}$ NE $\frac{1}{4}$ Section Number 27 Township Number T 11 S Range Number R 14 EW
 County: Shawnee

Distance and direction from nearest town or city street address of well if located within city? 1 mile east of Silver Lake on U.S. 24 to Hoch Rd., $1\frac{1}{2}$ mile south, $\frac{1}{4}$ mile west, & 600 ft. south.

2 WATER WELL OWNER: ~~X 333~~ Kibbee Farms
 RR#, St. Address, Box #: 1431 N.W. Humphrey Road Board of Agriculture, Division of Water Resources
 City, State, ZIP Code: Topeka Ks. 66608 Application Number: 39878

3 LOCATE WELL'S LOCATION WITH AN "X" IN SECTION BOX:

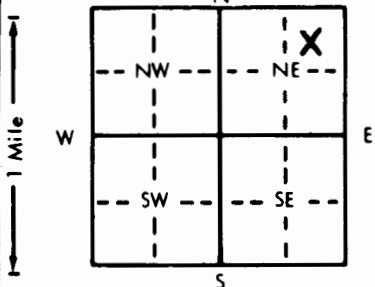

4 DEPTH OF COMPLETED WELL: 78 ft. ELEVATION:
 Depth(s) Groundwater Encountered 1. 17 ft. 2. ft. 3. ft.
 WELL'S STATIC WATER LEVEL: 17 ft. below land surface measured on mo/day/yr 6-29-90
 Pump test data: Well water was 41 ft. after 1 hours pumping 1,000 gpm
 Est. Yield 1,500 gpm: Well water was 56 ft. after 2 hours pumping 1,200 gpm
 Bore Hole Diameter: 32 in. to 78 ft., and in. to ft.
 WELL WATER TO BE USED AS:
 5 Public water supply 8 Air conditioning 11 Injection well
 1 Domestic 3 Feedlot 6 Oil field water supply 9 Dewatering 12 Other (Specify below)
 2 Irrigation 4 Industrial 7 Lawn and garden only 10 Monitoring well
 Was a chemical/bacteriological sample submitted to Department? Yes No ; If yes, mo/day/yr sample was submitted
 Water Well Disinfected? Yes No

5 TYPE OF BLANK CASING USED:
 1 Steel 3 RMP (SR) 5 Wrought iron 8 Concrete tile CASING JOINTS: Glued Clamped
 2 PVC 4 ABS 6 Asbestos-Cement 9 Other (specify below) Welded
 7 Fiberglass Threaded
 Blank casing diameter 16 in. to 58 ft., Dia in. to ft., Dia in. to ft.
 Casing height above land surface 12 in., weight lbs./ft. Wall thickness or gauge No. 65

TYPE OF SCREEN OR PERFORATION MATERIAL:
 1 Steel 3 Stainless steel 5 Fiberglass 7 PVC 10 Asbestos-cement
 2 Brass 4 Galvanized steel 6 Concrete tile 8 RMP (SR) 11 Other (specify)
 9 ABS 12 None used (open hole)

SCREEN OR PERFORATION OPENINGS ARE:
 1 Continuous slot 3 Mill slot 5 Gauzed wrapped 8 Saw cut 11 None (open hole)
 2 Louvered shutter 4 Key punched 6 Wire wrapped 9 Drilled holes
 7 Torch cut 10 Other (specify)

SCREEN-PERFORATED INTERVALS: From 58 ft. to 78 ft. ~~178~~ ft., From ft. to ft.
 From ft. to ft., From ft. to ft.
 GRAVEL PACK INTERVALS: From 17 ft. to 78 ft., From ft. to ft.
 From ft. to ft., From ft. to ft.

SPROUT MATERIAL: 1 Neat cement 2 Cement grout 3 Bentonite 4 Other
 Cut intervals: From 0 ft. to 17 ft., From ft. to ft., From ft. to ft.

What is the nearest source of possible contamination:
 1 Septic tank 4 Lateral lines 7 Pit privy 10 Livestock pens 14 Abandoned water well
 2 Sewer lines 5 Cess pool 8 Sewage lagoon 11 Fuel storage 15 Oil well/Gas well
 3 Watertight sewer lines 6 Seepage pit 9 Feedyard 12 Fertilizer storage 16 Other (specify below)
 13 Insecticide storage None

FROM	TO	LITHOLOGIC LOG	FROM	TO	PLUGGING INTERVALS
0	1	Brown sandy silt			
1	10	brown sand			
10	16	medium brown gravel			
16	18	fine brown sand			
18	31	medium brown gravel			
31	35	large brown gravel			
35	36	medium large grey gravel			
36	41	medium grey gravel			
41	44	medium large grey gravel and grey clay			
44	57	medium large grey gravel			
57	60	small grey sand			
60	77	medium grey gravel			
77	78	yellow until stopped			

7 CONTRACTOR'S OR LANDOWNER'S CERTIFICATION: This water well was (1) constructed, (2) reconstructed, or (3) plugged under my jurisdiction and was completed on (mo/day/year) 6-29-90 and this record is true to the best of my knowledge and belief. Kansas Water Well Contractor's License No. 323 This Water Well Record was completed on (mo/day/yr) 7-9-90 under the business name of Hoobler Drilling Co. by (signature)

INSTRUCTIONS: Use typewriter or ball point pen. PLEASE PRESS FIRMLY and PRINT clearly. Please fill in blanks, underline or circle the correct answers. Send three copies to Kansas Department of Health and Environment, Bureau of Water Protection, Topeka, Kansas 66620-7320. Telephone: 913-296-5514. Send one to WATER WELL OWNER and retain one for your records.