

| | | | | |
|--------------------------|-----------------------------|----------------|-----------------|-----------------------|
| 1 LOCATION OF WATER WELL | Fraction | Section Number | Township Number | Range Number |
| County: <u>SHAWNEE</u> | <u>SW 1/4 SW 1/4 NE 1/4</u> | <u>33</u> | T <u>11</u> S | R <u>14</u> <u>EW</u> |

Distance and direction from nearest town or city? _____ Street address of well if located within city? _____


2 WATER WELL OWNER: CLAUDE SHONTMAN
 RR#, St. Address, Box #: 10120 SW 10TH
 City, State, ZIP Code: TOPEKA KS
 Board of Agriculture, Division of Water Resources
 Application Number: _____

3 DEPTH OF COMPLETED WELL: 60' ft. Bore Hole Diameter: _____ in. to _____ ft., and _____ in. to 6 3/4" ft.
 Well Water to be used as:
 1 Domestic 3 Feedlot 6 Oil field water supply 9 Dewatering 11 Injection well
 2 Irrigation 4 Industrial 7 Lawn and garden only 10 Observation well 12 Other (Specify below) _____
 Well's static water level: 23 ft. below land surface measured on SEP 21 month 11 day 85 year
 Pump Test Data: _____ Well water was _____ ft. after _____ hours pumping _____ gpm
 Est. Yield _____ gpm: Well water was _____ ft. after _____ hours pumping _____ gpm

4 TYPE OF BLANK CASING USED:
 1 Steel 3 RMP (SR) 6 Asbestos-Cement 9 Other (specify below) _____
 2 PVC 4 ABS 7 Fiberglass _____
 Blank casing dia: 6 3/4" in. to _____ ft., Dia _____ in. to _____ ft., Dia _____ in. to _____ ft.
 Casing height above land surface: 24" in., weight 25 lbs./ft. Wall thickness or gauge No. _____
 TYPE OF SCREEN OR PERFORATION MATERIAL:
 1 Steel 3 Stainless steel UNKNOWN 7 PVC 10 Asbestos-cement
 2 Brass 4 Galvanized steel 6 Concrete tile 8 RMP (SR) 11 Other (specify) _____
 12 None used (open hole) _____
 Screen or Perforation Openings Are:
 1 Continuous slot 3 Mill slot 5 Gauzed wrapped 8 Saw cut 11 None (open hole)
 2 Louvered shutter 4 Key punched 6 Wire wrapped 9 Drilled holes
 7 Torch cut 10 Other (specify) _____
 Screen-Perforation Dia _____ in. to _____ ft., Dia _____ in. to _____ ft., Dia _____ in. to _____ ft.
 Screen-Perforated Intervals: From _____ ft. to _____ ft., From _____ ft. to _____ ft., From _____ ft. to _____ ft.
 Gravel Pack Intervals: From _____ ft. to _____ ft., From _____ ft. to _____ ft., From _____ ft. to _____ ft.

5 GROUT MATERIAL: 1 Neat cement 2 Cement grout 3 Bentonite 4 Other _____
 Grouted Intervals: From 4' ft. to UNKNOWN ft., From _____ ft. to _____ ft., From _____ ft. to _____ ft.
 What is the nearest source of possible contamination:
 1 Septic tank 4 Cess pool 7 Sewage lagoon 10 Fuel storage 2 14 Abandoned water well
 2 Sewer lines 5 Seepage pit 8 Feed yard 11 Fertilizer storage 15 Oil well/Gas well
 3 Lateral lines 6 Pit privy 9 Livestock pens 12 Insecticide storage 16 Other (specify below) _____
 13 Watertight sewer lines _____
 Direction from well: S.E. How many feet: 10 ? Water Well Disinfected? Yes _____ No _____
 Was a chemical/bacteriological sample submitted to Department? Yes _____ No _____ If yes, date sample was submitted _____ month _____ day _____ year: Pump Installed? Yes _____ No _____
 If Yes: Pump Manufacturer's name: GOULD'S Model No. 108J HP 1 Volts 230
 Depth of Pump Intake: 55' ft. Pumps Capacity rated at: 10 gal./min.
 Type of pump: 1 Submersible 2 Turbine 3 Jet 4 Centrifugal 5 Reciprocating 6 Other _____

6 CONTRACTOR'S OR LANDOWNER'S CERTIFICATION: This water well was (1) constructed, (2) reconstructed or (3) plugged under my jurisdiction and was completed on SEP 15 month 15 day 85 year, and this record is true to the best of my knowledge and belief. Kansas Water Well Contractor's License No. 119A
 This Water Well Record was completed on OCT 30 month 30 day 85 year under the business name of JUNGMANN Bros Drilling Co by (signature) Jam. B. J...

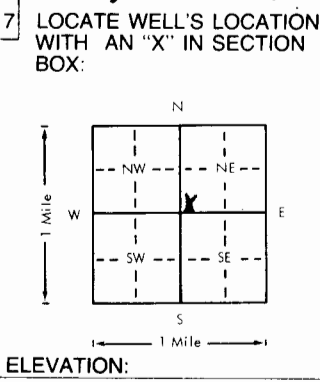

| FROM | TO | LITHOLOGIC LOG | FROM | TO | LITHOLOGIC LOG |
|------|----|---|------|----|----------------|
| | | WELL WAS STEEL CASING IN PIT OBVIOUS WELL WAS GRouted 5' STEEL 6" CASING ADAPTED ON PITLESS ADAPTED INSTALLED WELL SEAL AND VENT PIT MATERIAL REMOVED PIT BACK FILLED WITH EARTH | | | |
| | | APP 10' S.E. IS DUG AND DRILLED WELL DUGWELL BOUT LINED DRILLED WELL 3" STEEL IN CENTER OF DUG WELL APP. 10' FURTHER SOUTH THERE IS AN ABONDED DRILLED WELL IN PIT APP 30' SW IS ANOTHER DRILLED WELL IN PIT BEING USED | | | |

Depth(s) Groundwater Encountered 1. _____ ft. 2. _____ ft. 3. _____ ft. 4. _____ ft. (Use a second sheet if needed)

INSTRUCTIONS: Use typewriter or ball point pen, please press firmly and PRINT clearly. Please fill in blanks, underline or circle the correct answers. Send top three copies to Kansas Department of Health and Environment, Division of Environment, Water Well Contractors, Topeka, KS 66620. Send one to WATER WELL OWNER and retain one for your records.

OFFICE USE ONLY T R EW SEC 1/4 1/4 1/4