


1 LOCATION OF WATER WELL: Fraction SW 1/4 SE 1/4 NE 1/4 Section Number 13 Township Number T 11 S Range Number R 15 E/W
 County: Shawnee

Distance and direction from nearest town or city street address of well if located within city?
East side of Goodyear plant near railroad spurs

2 WATER WELL OWNER: Goodyear Tire Company Board of Agriculture, Division of Water Resources
 RR#, St. Address, Box # P.O. Box 1069, Topeka, Ks Application Number: _____
 City, State, ZIP Code

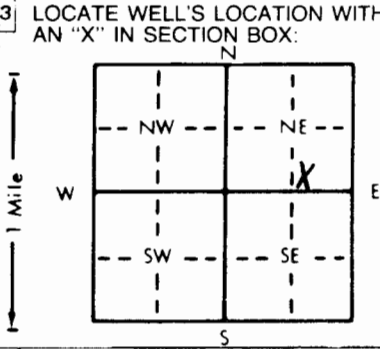

4 DEPTH OF COMPLETED WELL 37 ft. ELEVATION: _____
 Depth(s) Groundwater Encountered 1. 31.5 ft. 2. _____ ft. 3. _____ ft.
 WELL'S STATIC WATER LEVEL 28.5 ft. below land surface measured on mo/day/yr 1/22/96
 Pump test data: Well water was _____ ft. after _____ hours pumping _____ gpm
 Est. Yield _____ gpm Well water was _____ ft. after _____ hours pumping _____ gpm
 Bore Hole Diameter 8.625 in. to 3.7 ft. and _____ in. to _____ ft.
 WELL WATER TO BE USED AS: 5 Public water supply 8 Air conditioning 11 Injection well
 1 Domestic 3 Feedlot 6 Oil field water supply 9 Dewatering 12 Other (Specify below)
 2 Irrigation 4 Industrial 7 Lawn and garden only 10 Monitoring well
 Was a chemical/bacteriological sample submitted to Department? Yes _____ No X If yes, mo/day/yr sample was submitted _____
 Water Well Disinfected? Yes _____ No X

5 TYPE OF BLANK CASING USED: 5 Wrought iron 8 Concrete tile CASING JOINTS: Glued _____ Clamped _____
 1 Steel 3 RMP (SR) 6 Asbestos-Cement 9 Other (specify below) Welded _____
 2 PVC 4 ABS 7 Fiberglass Threaded X
 Blank casing diameter _____ in. to 22 ft. Dia _____ in. to _____ ft. Dia _____ in. to _____ ft.
 Casing height above land surface 0 in. weight SCH 40 PVC lbs./ft. Wall thickness or gauge No. _____
 TYPE OF SCREEN OR PERFORATION MATERIAL: 7 PVC 10 Asbestos-cement
 1 Steel 3 Stainless steel 5 Fiberglass 8 RMP (SR) 11 Other (specify) _____
 2 Brass 4 Galvanized steel 6 Concrete tile 9 ABS 12 None used (open hole)
 SCREEN OR PERFORATION OPENINGS ARE: 5 Gauzed wrapped 8 Saw cut 11 None (open hole)
 1 Continuous slot 3 Mill slot 6 Wire wrapped 9 Drilled holes
 2 Louvered shutter 4 Key punched 7 Torch cut 10 Other (specify) _____
 SCREEN-PERFORATED INTERVALS: From 22 ft. to 37 ft. From _____ ft. to _____ ft.
 From _____ ft. to _____ ft. From _____ ft. to _____ ft.
 SAND GRAVEL PACK INTERVALS: From 21 ft. to 37 ft. From _____ ft. to _____ ft.
 From _____ ft. to _____ ft. From _____ ft. to _____ ft.

6 GROUT MATERIAL: 2 Neat cement 19 2 Cement grout 19 3 Bentonite 4 Other _____
 Grout Intervals: From 0 ft. to 19 ft. From 19 ft. to 21 ft. From _____ ft. to _____ ft.
 What is the nearest source of possible contamination: 10 Livestock pens 14 Abandoned water well
 1 Septic tank 4 Lateral lines 7 Pit privy 11 Fuel storage 15 Oil well/Gas well
 2 Sewer lines 5 Cess pool 8 Sewage lagoon 12 Fertilizer storage 16 Other (specify below)
 3 Watertight sewer lines 6 Seepage pit 9 Feedyard 13 Insecticide storage Contamin. Site

Direction from well? _____ How many feet? _____

FROM	TO	LITHOLOGIC LOG	FROM	TO	PLUGGING INTERVALS
GL	5.00	Fill, gravel, rocks, black			
5.00	10.00	Clay silt, light brown, soft			
10.00	20.00	Clay, silt to slightly silty			
20.00	25.00	Clay, gray with brown mottles, low plastic			
25.00	30.00	Clay, brown with gray mottles, low plastic			
30.00	37.00	Sand, fine to medium gray			
37.00	TD	End of Borehole			

Flush Mount
 waiver
 D. Taylor

7 CONTRACTOR'S OR LANDOWNER'S CERTIFICATION: This water well was (1 constructed) (2) reconstructed, or (3) plugged under my jurisdiction and was completed on (mo/day/year) 1/22/96 and this record is true to the best of my knowledge and belief. Kansas Water Well Contractor's License No. 585. This Water Well Record was completed on (mo/day/yr) 2/6/96 under the business name of Associated Environmental, Inc. by (signature) Dawn Duncan by Dee Johnson