


1 LOCATION OF WATER WELL: Fraction **SW 1/4 SE 1/4 NE 1/4** Section Number **13** Township Number **T 11 S** Range Number **R 15 E/W**  
 County: **Shawnee**

Distance and direction from nearest town or city street address of well if located within city?  
**Goodyear Plant, West Hwy 24, Topeka, Kansas**

2 WATER WELL OWNER: **Goodyear Tire & Rubber Co.**  
 RR#, St. Address, Box # : **P.O. Box 1069** Board of Agriculture, Division of Water Resources  
 City, State, ZIP Code : **Topeka, KS 66601** Application Number:

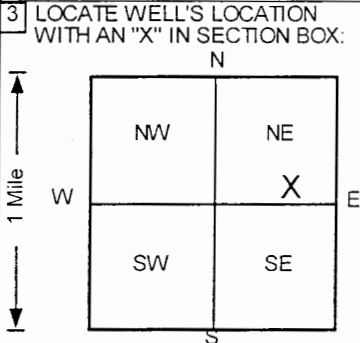

4 DEPTH OF COMPLETED WELL **43** ft. ELEVATION: .....  
 Depth(s) Groundwater Encountered 1. **38** ft. 2. .... ft. 3. .... ft.  
 WELL'S STATIC WATER LEVEL **38** ft. below land surface measured on mo/day/yr .....  
 Pump test data: Well water was **NA** ft. after ..... hours pumping ..... gpm  
 Est. Yield **NA** gpm: Well water was ..... ft. after ..... hours pumping ..... gpm  
 Bore Hole Diameter **8** in. to **43** ft., and ..... in. to ..... ft.  
 WELL WATER TO BE USED AS: 5 Public water supply 8 Air conditioning 11 Injection well  
 1 Domestic 3 Feedlot 6 Oil field water supply 9 Dewatering 12 Other (Specify below)  
 2 Irrigation 4 Industrial 7 Lawn and garden only **10** Monitoring well .....  
 Was a chemical/bacteriological sample submitted to Department? Yes.....No ; If yes, mo/day/yr sample was submitted  
 Water Well Disinfected? Yes No

5 TYPE OF BLANK CASING USED: 5 Wrought iron 8 Concrete tile CASING JOINTS: Glued ..... Clamped .....  
 1 Steel 3 RMP (SR) 6 Asbestos-Cement 9 Other (specify below) Welded .....  
**2** PVC 4 ABS 7 Fiberglass Threaded   
 Blank casing diameter **2** in. to **28** ft., Dia ..... in. to ..... ft., Dia ..... in. to ..... ft.  
 Casing height above land surface **0** in., weight **Sch 40** lbs./ft. Wall thickness or gauge No. ....  
 TYPE OF SCREEN OR PERFORATION MATERIAL **7** PVC 10 Asbestos-cement  
 1 Steel 3 Stainless steel 5 Fiberglass **8** RMP (SR) 11 Other (specify) .....  
 2 Brass 4 Galvanized steel 6 Concrete tile 9 ABS 12 None used (open hole)  
 SCREEN OR PERFORATION OPENINGS ARE: 5 Gauzed wrapped 8 Saw cut 11 None (open hole)  
 1 Continuous slot **3** Mill slot 6 Wire wrapped 9 Drilled holes  
 2 Louvered shutter 4 Key punched 7 Torch cut 10 Other (specify) .....  
 SCREEN-PERFORATED INTERVALS: From **28** ft. to **43** ft., From ..... ft. to ..... ft.  
 From ..... ft. to ..... ft., From ..... ft. to ..... ft.  
 GRAVEL PACK INTERVALS: From **26** ft. to **43** ft., From ..... ft. to ..... ft.  
 From ..... ft. to ..... ft., From ..... ft. to ..... ft.

6 GROUT MATERIAL: 1 Neat cement **2** Cement grout **3** Bentonite 4 Other .....  
 Grout Intervals: From **0** ft. to **23** ft., From **23** ft. to **26** ft., From ..... ft. to ..... ft.  
 What is the nearest source of possible contamination:  
 1 Septic tank 4 Lateral lines 7 Pit privy 10 Livestock pens 14 Abandoned water well  
 2 Sewer lines 5 Cess pool 8 Sewage lagoon 11 Fuel storage 15 Oil well/Gas well  
 3 Watertight sewer lines 6 Seepage pit 9 Feedyard 12 Fertilizer storage **16** Other (specify below)  
 .. **Unknown** .....  
 Direction from well? How many feet?

| FROM | TO | LITHOLOGIC LOG            | FROM | TO | PLUGGING INTERVALS              |
|------|----|---------------------------|------|----|---------------------------------|
| 0    | 2  | Concrete,                 |      |    |                                 |
| 2    | 5  | Silt, Brown               |      |    |                                 |
| 5    | 10 | Silt, Light to Dark Brown |      |    |                                 |
| 10   | 16 | Silt, Brown               |      |    |                                 |
| 16   | 20 | Silt, Light Brown         |      |    |                                 |
| 20   | 25 | Clay, Light Brown         |      |    |                                 |
| 25   | 30 | Clay, Gray                |      |    |                                 |
| 30   | 31 | Silt, Light Brown         |      |    |                                 |
| 31   | 38 | Silt, Dark Gray           |      |    |                                 |
| 38   | 43 | Sand, Gray                |      |    |                                 |
|      |    |                           |      |    |                                 |
|      |    |                           |      |    | MW1, Tag #, Flushmount          |
|      |    |                           |      |    | Project Name: Larsen - Goodyear |
|      |    |                           |      |    | GeoCore # 673, #                |

7 CONTRACTOR'S OR LANDOWNER'S CERTIFICATION: This water well was **1** constructed, (2) reconstructed, or (3) plugged under my jurisdiction and was completed on (mo/day/year) **5/18/98** and this record is true to the best of my knowledge and belief.  
 Kansas Water Well Contractor's License No. **527** This Water Well Record was completed on (mo/day/yr) **6/9/98**  
 under the business name of **GeoCore Services, Inc.** by (signature) *One Roll*

OFFICE USE ONLY  
T  
R  
EW  
SEC.  
1/4  
1/4  
1/4