


1 LOCATION OF WATER WELL: Fraction **SW ¼ SE ¼ NE ¼** Section Number **13** Township Number **T 11 S** Range Number **R 15** (E/W)

Distance and direction from nearest town or city street address of well if located within city?  
**Goodyear Plant, West Hwy 25, Topeka, Kansas**

2 WATER WELL OWNER: **Goodyear Tire & Rubber Co.**  
 RR#, St. Address, Box # : **P.O. Box 1069** Board of Agriculture, Division of Water Resources  
 City, State, ZIP Code : **Topeka, KS 66601** Application Number:

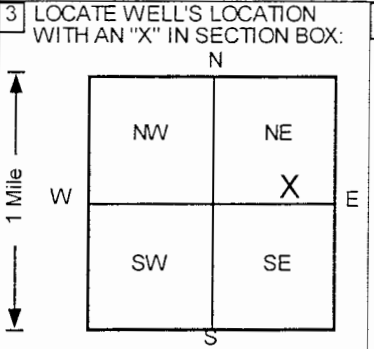

4 DEPTH OF COMPLETED WELL **40** ft. ELEVATION: .....

Depth(s) Groundwater Encountered 1. .... **33** ... ft. 2. .... ft. 3. .... ft.

WELL'S STATIC WATER LEVEL ..... ft. below land surface measured on mo/day/yr .....

Pump test data: Well water was .... **NA** ... ft. after ..... hours pumping ..... gpm  
 Est. Yield .. **NA** ... gpm: Well water was ..... ft. after ..... hours pumping ..... gpm

Bore Hole Diameter .... **8** ... in. to .... **40** ... ft., and, ..... in. to ..... ft.

WELL WATER TO BE USED AS: 5 Public water supply 8 Air conditioning 11 Injection well  
 1 Domestic 3 Feedlot 6 Oil field water supply 9 Dewatering 12 Other (Specify below)  
 2 Irrigation 4 Industrial 7 Lawn and garden only (10) Monitoring well .....

Was a chemical/bacteriological sample submitted to Department? Yes.....No✓.....; If yes, mo/day/yr sample was submitted  
 Water Well Disinfected? Yes No ✓

5 TYPE OF BLANK CASING USED: 5 Wrought iron 8 Concrete tile CASING JOINTS: Glued ..... Clamped .....  
 1 Steel 3 RMP (SR) 6 Asbestos-Cement 9 Other (specify below) Welded .....  
(2) PVC 4 ABS 7 Fiberglass ..... Threaded ✓

Blank casing diameter ..... **2** ... in. to .... **30** ... ft, Dia ..... in. to ..... ft, Dia ..... in. to ..... ft.  
 Casing height above land surface ..... **0** ... in, weight ..... **Sch 40** ... lbs./ft. Wall thickness or gauge No. ....

TYPE OF SCREEN OR PERFORATION MATERIAL (7) PVC 10 Asbestos-cement  
 1 Steel 3 Stainless steel 5 Fiberglass (8) RMP (SR) 11 Other (specify) .....

2 Brass 4 Galvanized steel 6 Concrete tile 9 ABS 12 None used (open hole)

SCREEN OR PERFORATION OPENINGS ARE: 5 Gauzed wrapped 8 Saw cut 11 None (open hole)  
 1 Continuous slot (3) Mill slot 6 Wire wrapped 9 Drilled holes  
 2 Louvered shutter 4 Key punched 7 Torch cut 10 Other (specify) .....

SCREEN-PERFORATED INTERVALS: From ..... **30** ... ft. to ..... **40** ... ft., From ..... ft. to ..... ft.  
 From ..... ft. to ..... ft., From ..... ft. to ..... ft.

GRAVEL PACK INTERVALS: From ..... **28** ... ft. to ..... **40** ... ft., From ..... ft. to ..... ft.  
 From ..... ft. to ..... ft., From ..... ft. to ..... ft.

6 GROUT MATERIAL: 1 Neat cement (2) Cement grout (3) Bentonite 4 Other .....

Grout Intervals: From ..... **0** ... ft. to .... **25** ... ft., From ..... **25** ... ft. to .... **28** ... ft., From ..... ft. to ..... ft.

What is the nearest source of possible contamination:

1 Septic tank 4 Lateral lines 7 Pit privy 10 Livestock pens 14 Abandoned water well  
 2 Sewer lines 5 Cess pool 8 Sewage lagoon 11 Fuel storage 15 Oil well/Gas well  
 3 Watertight sewer lines 6 Seepage pit 9 Feedyard 12 Fertilizer storage (16) Other (specify below)  
 ..... **Unknown** .....

Direction from well? How many feet?

FROM	TO	LITHOLOGIC LOG	FROM	TO	PLUGGING INTERVALS
<b>0</b>	<b>1</b>	Concrete,			
<b>1</b>	<b>14</b>	Fill Sand, Light Brown			
<b>14</b>	<b>15.5</b>	Sand, Light Brown			
<b>15.5</b>	<b>25</b>	Clay, Dark Brown			
<b>25</b>	<b>30</b>	Silt, Light Brown			
<b>30</b>	<b>33</b>	Clay, Light Gray Brown			
<b>33</b>	<b>40</b>	Sand, Light Gray Brown			
					<b>MW3 , Tag # , Flushmount</b>
					<b>Project Name: Larsen - Goodyear</b>
					<b>GeoCore # 673 , #</b>

7 CONTRACTOR'S OR LANDOWNER'S CERTIFICATION: This water well was (1) constructed, (2) reconstructed, or (3) plugged under my jurisdiction and was completed on (mo/day/year) ..... **5/20/98** ..... and this record is true to the best of my knowledge and belief.

Kansas Water Well Contractor's License No. .... **527** ..... This Water Well Record was completed on (mo/day/yr) ..... **6/9/98** .....  
 under the business name of **GeoCore Services, Inc.** by (signature) *[Signature]*