


1 LOCATION OF WATER WELL: County: Shawnee Fraction SW 1/4 SE 1/4 NE 1/4 Section Number 13 Township Number T 11 S Range Number R 15 EW

Distance and direction from nearest town or city street address of well if located within city? Goodyear Plant, West Hwy 25, Topeka, Kansas

2 WATER WELL OWNER: Goodyear Tire & Rubber Co. RR#, St. Address, Box #: P.O. Box 1069 City, State, ZIP Code: Topeka, KS 66601 Board of Agriculture, Division of Water Resources Application Number:

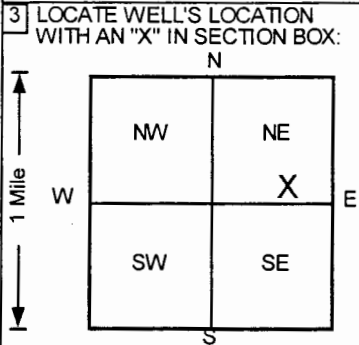

4 DEPTH OF COMPLETED WELL: 40 ft. ELEVATION: Depth(s) Groundwater Encountered 1. 30 ft. 2. ft. 3. ft. WELL'S STATIC WATER LEVEL: ft below land surface measured on mo/day/yr Pump test data: Well water was NA ft after hours pumping gpm Est. Yield NA gpm: Well water was ft after hours pumping gpm Bore Hole Diameter 8 in. to 40 ft. and in. to ft. WELL WATER TO BE USED AS: 5 Public water supply 8 Air conditioning 11 Injection well 1 Domestic 3 Feedlot 6 Oil field water supply 9 Dewatering 12 Other (Specify below) 2 Irrigation 4 Industrial 7 Lawn and garden only 10 Monitoring well Was a chemical/bacteriological sample submitted to Department: Yes No; If yes, mo/day/yr sample was submitted Water Well Disinfected? Yes No

5 TYPE OF BLANK CASING USED: 1 Steel 2 PVC 3 RMP (SR) 4 ABS 5 Wrought iron 6 Asbestos-Cement 7 Fiberglass 8 Concrete tile 9 Other (specify below) CASING JOINTS: Glued Clamped Welded Threaded. TYPE OF SCREEN OR PERFORATION MATERIAL: 1 Steel 2 Brass 3 Stainless steel 4 Galvanized steel 5 Fiberglass 6 Concrete tile 7 PVC 8 RMP (SR) 9 ABS 10 Asbestos-cement 11 Other (specify) 12 None used (open hole) SCREEN OR PERFORATION OPENINGS ARE: 1 Continuous slot 2 Louvered shutter 3 Mill slot 4 Key punched 5 Gauzed wrapped 6 Wire wrapped 7 Torch cut 8 Saw cut 9 Drilled holes 11 None (open hole) 10 Other (specify) SCREEN-PERFORATED INTERVALS: From 30 ft to 40 ft, From ft to ft, From ft to ft GRAVEL PACK INTERVALS: From 28 ft to 40 ft, From ft to ft, From ft to ft

6 GROUT MATERIAL: 1 Neat cement 2 Cement grout 3 Bentonite 4 Other Grout Intervals: From 0 ft to 25.5 ft, From 25.5 ft to 28 ft, From ft to ft What is the nearest source of possible contamination: 1 Septic tank 2 Sewer lines 3 Watertight sewer lines 4 Lateral lines 5 Cess pool 6 Seepage pit 7 Pit privy 8 Sewage lagoon 9 Feedyard 10 Livestock pens 11 Fuel storage 12 Fertilizer storage 13 Insecticide storage 14 Abandoned water well 15 Oil well/Gas well 16 Other (specify below) Unknown. Direction from well? How many feet?

Table with columns: FROM, TO, LITHOLOGIC LOG, FROM, TO, PLUGGING INTERVALS. Rows include: 0-7 Fill Sand, Light Brown; 7-17 Silt, Light Brown; 17-30 Clay, Light Brown; 30-40 Sand, Gray. Additional rows for MW4, Tag #, Flushmount; Project Name: Larsen - Goodyear; GeoCore # 673, #

7 CONTRACTOR'S OR LANDOWNER'S CERTIFICATION: This water well was (1) constructed, (2) reconstructed, or (3) plugged under my jurisdiction and was completed on (mo/day/year) 5/20/98 and this record is true to the best of my knowledge and belief. Kansas Water Well Contractor's License No. 527 This Water Well Record was completed on (mo/day/yr) 6/9/98 under the business name of GeoCore Services, Inc. by (signature) Dan Roll