

1 LOCATION OF WATER WELL:	Fraction	Section Number	Township Number	Range Number
County: Shawnee	NW 1/4 NW 1/4 SE 1/4	13	T 11 S	R 15 E/W

Distance and direction from nearest town or city street address of well if located within city?

Not Available

2 WATER WELL OWNER: Goodyear Tire & Rubber Co.

RR#, St. Address, Box #: P O Box 1069


Board of Agriculture, Division of Water Resources

City, State, ZIP Code: Topeka, Kansas 66601

Application Number: 37984

3 LOCATE WELL'S LOCATION WITH AN "X" IN SECTION BOX:

4 DEPTH OF COMPLETED WELL: 82.0' ft. ELEVATION:

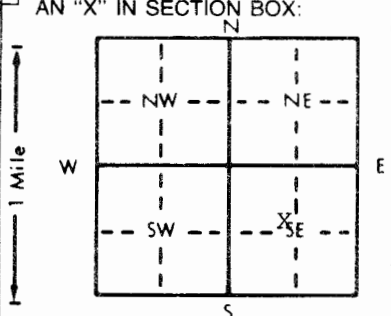

Depth(s) Groundwater Encountered 1. ft. 2. ft. 3. ft.

WELL'S STATIC WATER LEVEL ft. below land surface measured on mo/day/yr

Pump test data: Well water was ft. after hours pumping gpm

Est. Yield gpm: Well water was ft. after hours pumping gpm

Bore Hole Diameter .22 in. to 82.0' ft. and in. to ft.

WELL WATER TO BE USED AS: 5 Public water supply 8 Air conditioning 11 Injection well

1 Domestic 3 Feedlot 6 Oil field water supply **9 Dewatering** 12 Other (Specify below)

2 Irrigation 4 Industrial 7 Lawn and garden only 10 Monitoring well

Was a chemical/bacteriological sample submitted to Department? Yes No **X** If yes, mo/day/yr sample was submittedWater Well Disinfected? Yes **X** No

5 TYPE OF BLANK CASING USED:

5 Wrought iron

8 Concrete tile

CASING JOINTS: Glued Clamped

1 Steel

3 RMP (SR)

6 Asbestos-Cement

9 Other (specify below)

Welded

2 PVC

4 ABS

7 Fiberglass

Threaded

Blank casing diameter 12 in. to 62.0' ft. Dia in. to ft. Dia in. to ft.

Casing height above land surface 2.0' in. weight lbs./ft. Wall thickness or gauge No.

TYPE OF SCREEN OR PERFORATION MATERIAL:

1 Steel

3 Stainless steel

5 Fiberglass

7 PVC

10 Asbestos-cement

2 Brass

4 Galvanized steel

6 Concrete tile

8 RMP (SR)

11 Other (specify)

12 None used (open hole)

SCREEN OR PERFORATION OPENINGS ARE:

5 Gauzed wrapped

3 Saw cut

11 None (open hole)

1 Continuous slot

3 Mill slot

6 Wire wrapped

9 Drilled holes

2 Louvered shutter

4 Key punched

7 Torch cut

10 Other (specify)

SCREEN-PERFORATED INTERVALS: From 62.0' ft. to 82.0' ft. From ft. to ft.

From ft. to ft. From ft. to ft.

GRAVEL PACK INTERVALS: From 42.0' ft. to 82.0' ft. From ft. to ft.

From ft. to ft. From ft. to ft.

6 GROUT MATERIAL:

1 Neat cement

2 Cement grout

3 Bentonite

4 Other

Grout Intervals: From 35 ft. to 42 ft. From ft. to ft. From ft. to ft.

What is the nearest source of possible contamination:

1 Septic tank

4 Lateral lines

7 Pit privy

10 Livestock pens

14 Abandoned water well

2 Sewer lines

5 Cess pool

8 Sewage lagoon

11 Fuel storage

15 Oil well/Gas well

3 Watertight sewer lines

6 Seepage pit

9 Feedyard

12 Fertilizer storage

16 Other (specify below)

13 Insecticide storage

Direction from well? East

How many feet? 400'

FROM	TO	LITHOLOGIC LOG	FROM	TO	PLUGGING INTERVALS
0.0'	3.0'	Brown silty clay, fill	0.0'	10.0'	Concrete
3.0'	6.0'	Dark gray clay, stiff	10.0'	83.0'	Sand fill
6.0'	38.0'	Brown silty clay, very stiff			
38.0'	63.0'	Brown coarse to med. sand & gravel			
63.0'	81.3'	Gray brown coarse to med. sand, w/trace fine sand, gravel & boulders			
81.3'	83.0'	Green & tan clayey shale, weathered			
83.0'		TOTAL DEPTH			

7 CONTRACTOR'S OR LANDOWNER'S CERTIFICATION: This water well was (1) constructed, (2) reconstructed, or **(3) plugged** under my jurisdiction and wascompleted on (mo/day/year) ~~8-11-85~~ 1-16-86 and this record is true to the best of my knowledge and belief. KansasWater Well Contractor's License No. ~~429~~ This Water Well Record was completed on (mo/day/yr) 8-10-88

under the business name of Scandia, Inc. by (signature) M.T. Osterberg