


1 LOCATION OF WATER WELL: Fraction SW 1/4 SE 1/4 NW 1/4 Section Number 29 Township Number T 11 S Range Number R 15 EW  
 County: SHAWNEE

Distance and direction from nearest town or city street address of well if located within city?

1 mile west of Topeka

2 WATER WELL OWNER: Meiers Ready Mix  
 RR#, St. Address, Box #: 1401 N.W. Hwy 24 Board of Agriculture, Division of Water Resources  
 City, State, ZIP Code: Topeka, KS 66608 Application Number:

3 LOCATE WELL'S LOCATION WITH AN "X" IN SECTION BOX:

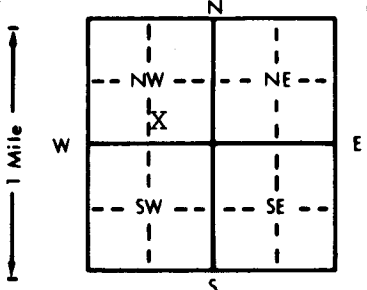

4 DEPTH OF COMPLETED WELL: 57' ft. ELEVATION:  
 Depth(s) Groundwater Encountered 1. . . . . ft. 2. . . . . ft. 3. . . . . ft.  
 WELL'S STATIC WATER LEVEL . . . . . ft. below land surface measured on mo/day/yr  
 Pump test data: Well water was 36' - 8" . . . . . ft. after 2 . . . . . hours pumping 1250 . . . . . gpm  
 Est. Yield 1,250 gpm: Well water was 38' . . . . . ft. after 4 . . . . . hours pumping 1250 . . . . . gpm  
 Bore Hole Diameter . 24" . . . . . in. to . . . . . ft. and . . . . . in. to . . . . . ft.  
 WELL WATER TO BE USED AS: 5 Public water supply 8 Air conditioning 11 Injection well  
 1 Domestic 3 Feedlot 6 Oil field water supply 9 Dewatering 12 Other (Specify below)  
 2 Irrigation 4 Industrial 7 Lawn and garden only 10 Monitoring well . . . . .  
 Was a chemical/bacteriological sample submitted to Department? Yes . . . . . No . . . . . X . . . . .; If yes, mo/day/yr sample was submitted  
 Water Well Disinfected? Yes X No

5 TYPE OF BLANK CASING USED: 5 Wrought iron 8 Concrete tile CASING JOINTS: Glued . . . . . Clamped . . . . .  
 1 Steel 3 RMP (SR) 6 Asbestos-Cement 9 Other (specify below) Welded . X . . . . .  
 2 PVC 4 ABS 7 Fiberglass . . . . . Threaded . . . . .  
 Blank casing diameter . . . 10" . . . . . in. to . . . 0-49 . . . . . ft., Dia . . . . . in. to . . . . . ft., Dia . . . . . in. to . . . . . ft.  
 Casing height above land surface . . . . . in., weight . . . 40 . . . . . lbs./ft. Wall thickness or gauge No. . . 365 . . . . .  
 TYPE OF SCREEN OR PERFORATION MATERIAL: 100 slot 7 PVC 10 Asbestos-cement  
 1 Steel 3 Stainless steel 5 Fiberglass 8 RMP (SR) 11 Other (specify) . . . . .  
 2 Brass 4 Galvanized steel 6 Concrete tile 9 ABS 12 None used (open hole)  
 SCREEN OR PERFORATION OPENINGS ARE: 5 Gauzed wrapped 8 Saw cut 11 None (open hole)  
 1 Continuous slot 3 Mill slot 6 Wire wrapped 9 Drilled holes  
 2 Louvered shutter 4 Key punched 7 Torch cut 10 Other (specify) . . . . .  
 SCREEN-PERFORATED INTERVALS: From . . . 49 . . . . . ft. to . . . 57 . . . . . ft., From . . . . . ft. to . . . . . ft.  
 From . . . . . ft. to . . . . . ft., From . . . . . ft. to . . . . . ft.  
 GRAVEL PACK INTERVALS: From . . . 35 . . . . . ft. to . . . 57 . . . . . ft., From . . . . . ft. to . . . . . ft.  
 From . . . . . ft. to . . . . . ft., From . . . . . ft. to . . . . . ft.

6 GROUT MATERIAL: 1 Neat cement 2 Cement grout 3 Bentonite 4 Other Fill Sand  
 Grout Intervals: From . . . 4 . . . . . ft. to . . . 24 . . . . . ft., From . . . . . ft. to . . . . . ft., From . . . 24 . . . . . ft. to . . . 35 . . . . . ft.  
 What is the nearest source of possible contamination:  
 1 Septic tank 4 Lateral lines 7 Pit privy 10 Livestock pens 14 Abandoned water well  
 2 Sewer lines 5 Cess pool 8 Sewage lagoon 11 Fuel storage 15 Oil well/Gas well  
 3 Watertight sewer lines 6 Seepage pit 9 Feedyard 12 Fertilizer storage 16 Other (specify below)  
 13 Insecticide storage . . . . . Kansas River . . . . .

Direction from well? North How many feet? 300'

FROM	TO	LITHOLOGIC LOG	FROM	TO	PLUGGING INTERVALS
0	2	Fill			
2	10	Silty Clay-Brown			
10	18	Silt-Brown			
18	25	Fine Sand-Coarse Sand-Med Gravel-Brown			
25	47	FS-CS-Med-Pea 1/4x3/8			
47	48	Boulders			
48	51	FS-Cs-Med-Pea Gravel 1/4x3/8			
51	52	Boulders			
52	61	FS-CS-Med-Pea Gravel 1/4			
61		Clay-Blue			

7 CONTRACTOR'S OR LANDOWNER'S CERTIFICATION: This water well was (1) constructed, (2) reconstructed, or (3) plugged under my jurisdiction and was completed on (mo/day/year) . . . 03/23/98 . . . . . and this record is true to the best of my knowledge and belief. Kansas Water Well Contractor's License No. . . 182 . . . . . This Water Well Record was completed on (mo/day/yr) 4-14-98 . . . . . under the business name of STRADER DRILLING CO., INC. by (signature) Dale Hansen

INSTRUCTIONS: Use typewriter or ball point pen. PLEASE PRESS FIRMLY and PRINT clearly. Please fill in blanks, underline or circle the correct answers. Send top three copies to Kansas Department of Health and Environment, Bureau of Water, Topeka, Kansas 66620-0001. Telephone: 913-296-5545. Send one to WATER WELL OWNER and retain one for your records.

OFFICE USE ONLY T R EW SEC. 1/4 1/4 1/4