


1 LOCATION OF WATER WELL: County: Cherokee County Fraction: NE 1/4 SW 1/4 NE 1/4 Section Number: 34 Township Number: T 11 S Range Number: R 15 EW

Distance and direction from nearest town or city street address of well if located within city?
4320 SW 10th, Topeka, KS

2 WATER WELL OWNER: City of Topeka
 RR#, St. Address, Box #: 215 SE 7th St Rm 215 Board of Agriculture, Division of Water Resources
 City, State, ZIP Code: Topeka, KS 66603 Application Number:

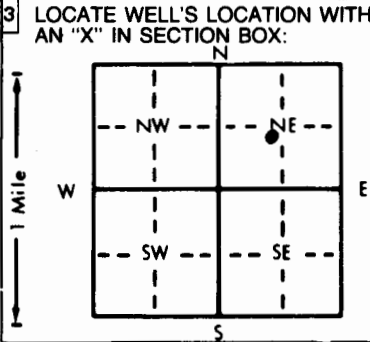

4 DEPTH OF COMPLETED WELL: 20' ft. ELEVATION:
 Depth(s) Groundwater Encountered: 1 10' ft. 2. ft. 3. ft.
 WELL'S STATIC WATER LEVEL: 9.95 ft. below land surface measured on mo/day/yr 2-25-98
 Pump test data: Well water was _____ ft. after _____ hours pumping _____ gpm
 Est. Yield _____ gpm; Well water was _____ ft. after _____ hours pumping _____ gpm
 Bore Hole Diameter: 8 1/2" in. to 20' ft., and _____ in. to _____ ft.
 WELL WATER TO BE USED AS:
 1 Domestic 2 Irrigation 3 Feedlot 4 Industrial 5 Public water supply 6 Oil field water supply 7 Lawn and garden only 10 Monitoring well 8 Air conditioning 9 Dewatering 11 Injection well 12 Other (Specify below)
 Was a chemical/bacteriological sample submitted to Department? Yes _____ No X; If yes, mo/day/yr sample was submitted _____
 Water Well Disinfected? Yes _____ No 10

5 TYPE OF BLANK CASING USED:
 1 Steel 2 PVC 3 RMP (SR) 4 ABS 5 Wrought iron 6 Asbestos-Cement 7 Fiberglass 8 Concrete tile 9 Other (specify below)
 Blank casing diameter: 2.375 in. to 10' ft., Dia. _____ in. to _____ ft., Dia. _____ in. to SDR 13 ft.
 Casing height above land surface: Flush Mt. in., weight _____ lbs./ft. Wall thickness or gauge No. SCH 40
 TYPE OF SCREEN OR PERFORATION MATERIAL:
 1 Steel 2 Brass 3 Stainless steel 4 Galvanized steel 5 Fiberglass 6 Concrete tile 7 PVC 8 RMP (SR) 9 ABS 10 Asbestos-cement 11 Other (specify) 12 None used (open hole)
 SCREEN OR PERFORATION OPENINGS ARE:
 1 Continuous slot 2 Louvered shutter 3 3 Mill slot 4 Key punched 5 Gauzed wrapped 6 Wire wrapped 7 Torch cut 8 Saw cut 9 Drilled holes 10 Other (specify) 11 None (open hole)
 SCREEN-PERFORATED INTERVALS: From 20' ft. to 10' ft., From _____ ft. to _____ ft.
 GRAVEL PACK INTERVALS: From 20' ft. to 8' ft., From _____ ft. to _____ ft.

6 GROUT MATERIAL: 1 Neat cement 2 3 Cement grout 3 2 Bentonite 4 Other
 Grout Intervals: From 8' ft. to 3' ft., From 3' ft. to 0' ft., From _____ ft. to _____ ft.
 What is the nearest source of possible contamination:
 1 Septic tank 2 Sewer lines 3 Watertight sewer lines 4 Lateral lines 5 Cess pool 6 Seepage pit 7 Pit privy 8 Sewage lagoon 9 Feedyard 10 Livestock pens 11 Fuel Fuel storage 12 Fertilizer storage 13 Insecticide storage 14 Abandoned water well 15 Oil well/Gas well 16 Other (specify below)
 Direction from well? In old Pit How many feet? 0'

FROM	TO	LITHOLOGIC LOG	FROM	TO	PLUGGING INTERVALS
0	.5	Top soil and gravel			
.5	5	Fill sand and some clay			
5	10	A/A sand and clay backfill			
9.5	10	Dk gray silty clay and sand (top native)			
10	15	Fill material (all above was fill) sand clay 14-15' very silty-very sandy brn, gray, dk gray			
15	20	Interbedded clay and sand m grained (coarse) sand-poorly sorted rounded-angular clay-very silty, very sandy			

F.M. OK'd by D. Taylor

7 CONTRACTOR'S OR LANDOWNER'S CERTIFICATION: This water well was (1) constructed, (2) reconstructed, or (3) plugged under my jurisdiction and was completed on (mo/day/year) 2-24-98 and this record is true to the best of my knowledge and belief. Kansas Water Well Contractor's License No. 539 This Water Well Record was completed on (mo/day/yr) 5-8-98 under the business name of JB Environmental Drilling by (signature) James Bieber

OFFICE USE ONLY