


Mu-7

1 LOCATION OF WATER WELL: Fraction SW 1/4 SW 1/4 SE 1/4 Section Number 35 Township Number T 11 S Range Number R 15  
 County: Shawnee

Distance and direction from nearest town or city street address of well if located within city?  
1243 Warren Ave, Topeka

2 WATER WELL OWNER: John Lincoln  
 RR#, St. Address, Box #: 1243 Warren Ave  
 City, State, ZIP Code: Topeka, KS 66604  
 Board of Agriculture, Division of Water Resources  
 Application Number:

3 LOCATE WELL'S LOCATION WITH AN "X" IN SECTION BOX:

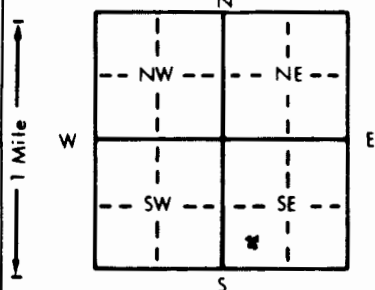

4 DEPTH OF COMPLETED WELL: 20.0 ft. ELEVATION:

Depth(s) Groundwater Encountered 1. 14.8 ft. 2. — ft. 3. — ft.  
 WELL'S STATIC WATER LEVEL: 8.76 ft. below land surface measured on mo/day/yr 4/6/94  
 Pump test data: Well water was — ft. after — hours pumping — gpm  
 Est. Yield — gpm: Well water was — ft. after — hours pumping — gpm  
 Bore Hole Diameter: 8.625 in. to 20.0 ft., and — in. to — ft.  
 WELL WATER TO BE USED AS:  
 5 Public water supply 8 Air conditioning 11 Injection well  
 1 Domestic 3 Feedlot 6 Oil field water supply 9 Dewatering 12 Other (Specify below)  
 2 Irrigation 4 Industrial 7 Lawn and garden only 10 Monitoring well  
 Was a chemical/bacteriological sample submitted to Department? Yes — No X; If yes, mo/day/yr sample was submitted —  
 Water Well Disinfected? Yes — No X

5 TYPE OF BLANK CASING USED:  
 1 Steel 3 RMP (SR) 5 Wrought iron 8 Concrete tile CASING JOINTS: Glued — Clamped —  
 2 PVC 4 ABS 6 Asbestos-Cement 9 Other (specify below) Welded —  
 7 Fiberglass Threaded X

Blank casing diameter: 2 in. to 9.0 ft. Dia. — in. to — ft. Dia. — in. to — ft.  
 Casing height above land surface: Flush Mount in., weight Sch 40 lbs./ft. Wall thickness or gauge No. —

TYPE OF SCREEN OR PERFORATION MATERIAL:  
 1 Steel 3 Stainless steel 5 Fiberglass 7 PVC 10 Asbestos-cement  
 2 Brass 4 Galvanized steel 6 Concrete tile 8 RMP (SR) 11 Other (specify) —  
 9 ABS 12 None used (open hole)

SCREEN OR PERFORATION OPENINGS ARE:  
 1 Continuous slot 3 Mill slot 5 Gauzed wrapped 8 Saw cut 11 None (open hole)  
 2 Louvered shutter 4 Key punched 6 Wire wrapped 9 Drilled holes  
 7 Torch cut 10 Other (specify) —

SCREEN-PERFORATED INTERVALS: From — ft. to 19 ft. From — ft. to — ft.  
sand From 7 ft. to 20 ft. From — ft. to — ft.  
GRAVEL PACK INTERVALS: From — ft. to — ft. From — ft. to — ft.

6 GROUT MATERIAL: 1 Neat cement 2 Cement grout 3 Bentonite 4 Other —  
 Grout Intervals: From GL ft. to 5 ft. From 5 ft. to 7 ft. From — ft. to — ft.

What is the nearest source of possible contamination:  
 1 Septic tank 4 Lateral lines 7 Pit privy 10 Livestock pens 14 Abandoned water well  
 2 Sewer lines 5 Cess pool 8 Sewage lagoon 11 Fuel storage 15 Oil well/Gas well  
 3 Watertight sewer lines 6 Seepage pit 9 Feedyard 12 Fertilizer storage 16 Other (specify below) Contaminated Site  
 13 Insecticide storage  
 Direction from well? West How many feet? 75 FT

| FROM       | TO         | LITHOLOGIC LOG  | FROM | TO | PLUGGING INTERVALS |
|------------|------------|---|------|----|--------------------|
| <u>GL</u>  | <u>1.5</u> | <u>Soil</u>   |      |    |                    |
| <u>1.5</u> | <u>4.5</u> | <u>Silty Clay, dk gray, stiff</u>                         |      |    |                    |
| <u>4.5</u> | <u>9.2</u> | <u>Clayey silt, brown, stiff</u>                          |      |    |                    |
| <u>9.2</u> | <u>11</u>  | <u>Siltstone, tan</u>                                     |      |    |                    |
| <u>11</u>  | <u>20</u>  | <u>shale, tan, hard saturated lease @ approx. 14.8 FT</u> |      |    |                    |
| <u>TD</u>  | <u>20</u>  |   |      |    |                    |

7 CONTRACTOR'S OR LANDOWNER'S CERTIFICATION: This water well was (1) constructed, (2) reconstructed, or (3) plugged under my jurisdiction and was completed on (mo/day/year) 06-01-94 and this record is true to the best of my knowledge and belief. Kansas Water Well Contractor's License No. 479 This Water Well Record was completed on (mo/day/yr) 06-22-94 under the business name of EBBERTS DRILLING by (signature) Greg Ebberts