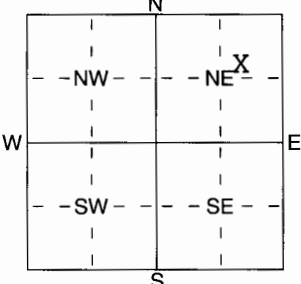


1 LOCATION OF WATER WELL: Fraction SW 1/4 NE 1/4 Section Number 22 Township Number T 11 S Range Number R 15 EW
 County: Shawnee

Distance and direction from nearest town or city street address of well if located within city?
5135 NW Highway 24 Topeka, Kansas

2 WATER WELL OWNER: Cargill Ag Horizons
 RR#, St. Address, Box # : PO Box 750780 Board of Agriculture, Division of Water Resources
 City, State, ZIP Code : Topeka, KS 66675 Application Number:

3 LOCATE WELL'S LOCATION WITH AN "X" IN SECTION BOX:

 4 DEPTH OF COMPLETED WELL 37 ft. ELEVATION: ft.
 Depth(s) Groundwater Encountered: 1 ft. 2 ft. 3 1/12/05 ft.
 WELL'S STATIC WATER LEVEL 30 ft. below land surface measured on mo/day/yr 7/12/05
 Pump test data: Well water was ft. after hours pumping gpm
 Est. Yield gpm: Well water was ft. after hours pumping gpm
 WELL WATER TO BE USED AS: 5 Public water supply 8 Air conditioning 11 Injection well
 1 Domestic 3 Feedlot 6 Oil field water supply 9 Dewatering 12 Other (Specify below)
 2 Irrigation 4 Industrial 7 Domestic (lawn & garden) 10 Monitoring well
 Was a chemical/bacteriological sample submitted to Department? Yes No X; If yes, mo/day/yr sample was submitted
 Water Well Disinfected? Yes No X

5 TYPE OF BLANK CASING USED: 5 Wrought iron 8 Concrete tile CASING JOINTS: Glued Clamped
 1 Steel 3 RMP (SR) 6 Asbestos-Cement 9 Other (specify below) Welded
2 PVC 4 ABS 7 Fiberglass Threaded X
 Blank casing diameter 2 in. to 27 ft., Dia in. to ft., Dia in. to ft.
 Casing height above land surface 36 in., weight sch 40 lbs./ft. Wall thickness or gauge No.
 TYPE OF SCREEN OR PERFORATION MATERIAL: 7 PVC 10 Asbestos-Cement
 1 Steel 3 Stainless Steel 5 Fiberglass 8 RMP (SR) 11 Other (Specify)
 2 Brass 4 Galvanized Steel 6 Concrete tile 9 ABS 12 None used (open hole)
 SCREEN OR PERFORATION OPENINGS ARE: 5 Gauzed wrapped 8 Saw cut 11 None (open hole)
 1 Continuous slot 3 Mill slot .010 6 Wire wrapped 9 Drilled holes
 2 Louvered shutter 4 Key punched 7 Torch cut 10 Other (specify) ft.
 SCREEN-PERFORATED INTERVALS: From 37 ft. to 27 ft., From ft. to ft.
 From ft. to ft., From ft. to ft.
 GRAVEL PACK INTERVALS: From ft. to ft., From ft. to ft.
 From 37 ft. to 29.3 ft., From ft. to ft.
10/20

6 GROUT MATERIAL: 1 Neat cement 2 Cement grout 3 Bentonite 4 Other Bentonite Grout
 Grout Intervals: From 29.3 ft. to 0 ft., From ft. to ft., From ft. to ft.
 What is the nearest source of possible contamination:
 1 Septic tank 4 Lateral lines 7 Pit privy 10 Livestock pens 14 Abandoned water well
 2 Sewer lines 5 Cess pool 8 Sewage lagoon 11 Fuel storage 15 Oil well/Gas well
3 Watertight sewer lines 6 Seepage pit 9 Feedyard 12 Fertilizer storage 16 Other (specify below)
 13 Insecticide storage
 Direction from well? NW How many feet? 150

FROM	TO	LITHOLOGIC LOG	FROM	TO	PLUGGING INTERVALS
0	5	Topsoil	37	29.3	10/20 Gravel Pack
5	25	Brown Plastic Clay	29.3	27.3	3/8 Bentonite chips
25	40	Sand & Gravel	27.3	0	TTTTT Voclay Grout
					MW 8A

7 CONTRACTOR'S OR LANDOWNER'S CERTIFICATION: This water well was (1) constructed, (2) reconstructed, or (3) plugged under my jurisdiction and was completed on (mo/day/year) 7/11/05 and this record is true to the best of my knowledge and belief. Kansas Water Well Contractor's Licence No 665 This Water Well Record was completed on (mo/day/yr) 7/14/05 under the business name of Pratt Well Environmental by (signature) Steven E. Pratt