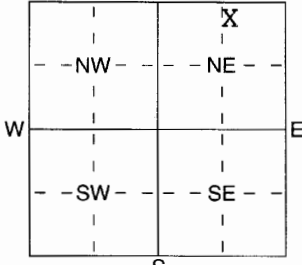


1 LOCATION OF WATER WELL: Fraction NW 1/4 NE 1/4 NE 1/4 Section Number 22 Township Number T 11 S Range Number R 15 E/W

Distance and direction from nearest town or city street address of well if located within city?  
 5135 NW Highway 24 - Topeka, Kansas

2 WATER WELL OWNER: Cargill Ag Horizons  
 RR#, St. Address, Box # : PO Box 750780 Board of Agriculture, Division of Water Resources  
 City, State, ZIP Code : Topeka, KS 66675 Application Number:

3 LOCATE WELL'S LOCATION WITH AN "X" IN SECTION BOX:  
  
 4 DEPTH OF COMPLETED WELL 89.4 ft. ELEVATION:  
 Depth(s) Groundwater Encountered 1 ..... ft. 2 ..... ft. 3 ..... ft.  
 WELL'S STATIC WATER LEVEL 29.9 ft. below land surface measured on mo/day/yr 7/7/05  
 Pump test data: Well water was ..... ft. after ..... hours pumping ..... gpm  
 Est. Yield ..... gpm: Well water was ..... ft. after ..... hours pumping ..... gpm  
 WELL WATER TO BE USED AS: 5 Public water supply 8 Air conditioning 11 Injection well  
 1 Domestic 3 Feedlot 6 Oil field water supply 9 Dewatering 12 Other (Specify below)  
 2 Irrigation 4 Industrial 7 Domestic (lawn & garden) 10 Monitoring well  
 Was a chemical/bacteriological sample submitted to Department? Yes ..... No X.....; If yes, mo/day/yr sample was submitted  
 Water Well Disinfected? Yes ..... No X.....

5 TYPE OF BLANK CASING USED:  
 1 Steel 3 RMP (SR) 5 Wrought iron 8 Concrete tile CASING JOINTS: Glued ..... Clamped .....  
 2 PVC 4 ABS 6 Asbestos-Cement 9 Other (specify below) Welded .....  
 Blank casing diameter 2 ..... in. to 78.4 ..... ft., Dia ..... in. to ..... ft., Dia ..... in. to ..... ft.  
 Casing height above land surface -2 ..... in., weight sch 40 ..... lbs./ft. Wall thickness or gauge No. ....  
 TYPE OF SCREEN OR PERFORATION MATERIAL:  
 1 Steel 3 Stainless Steel 5 Fiberglass 8 RMP (SR) 10 Asbestos-Cement  
 2 Brass 4 Galvanized Steel 6 Concrete tile 9 ABS 11 Other (Specify) .....  
 12 None used (open hole)  
 SCREEN OR PERFORATION OPENINGS ARE:  
 1 Continuous slot 3 Mill slot 0.010 5 Gauzed wrapped 8 Saw cut 11 None (open hole)  
 2 Louvered shutter 4 Key punched 6 Wire wrapped 9 Drilled holes  
 7 Torch cut 10 Other (specify) ..... ft.  
 SCREEN-PERFORATED INTERVALS: From 89.4 ..... ft. to 78.4 ..... ft., From ..... ft. to ..... ft.  
 GRAVEL PACK INTERVALS: From ..... ft. to ..... ft., From ..... ft. to ..... ft.  
 10/20

6 GROUT MATERIAL: 1 Neat cement 2 Cement grout 3 Bentonite 4 Other .....  
 Grout Intervals: From 31.2 ..... ft. to 0 ..... ft., From ..... ft. to ..... ft., From ..... ft. to ..... ft.  
 What is the nearest source of possible contamination:  
 1 Septic tank 4 Lateral lines 7 Pit privy 10 Livestock pens 14 Abandoned water well  
 2 Sewer lines 5 Cess pool 8 Sewage lagoon 11 Fuel storage 15 Oil well/Gas well  
 3 Watertight sewer lines 6 Seepage pit 9 Feedyard 12 Fertilizer storage 16 Other (specify below)  
 13 Insecticide storage .....  
 Direction from well? North How many feet? 25

FROM	TO	LITHOLOGIC LOG	FROM	TO	PLUGGING INTERVALS
0	5	Topsoil			
5	10	Dark Brown Clay			
10	15	Tan Clay			
15	30	Tan Clay fatty			
30	35	Clay to sand			
35	90	Sand gravel			MW-3C

7 CONTRACTOR'S OR LANDOWNER'S CERTIFICATION: This water well was (1) constructed, (2) reconstructed, or (3) plugged under my jurisdiction and was completed on (mo/day/year) 7/7/05 and this record is true to the best of my knowledge and belief. Kansas Water Well Contractor's Licence No 665 This Water Well Record was completed on (mo/day/yr) 7/14/05 under the business name of Pratt Well Environmental by (signature) *Steven Gill*