

KANSAS DEPARTMENT OF TRANSPORTATION

COUNTY *Shownee* PROJECT NO. *70-89-K-2446-01* BRIDGE NO. *10.71*

DESCRIPTION *Fair lawn Rd over I-70* STA. *78+83.111' Lt & Handline*

GEOLOGIST *Clarke* VERTICAL SCALE *1" = 10'* DATE *Mar 1990*

BIT TYPE & NO.	GEOLOGIC NAME	GEOLOGIC COLUMN	GROUNDWATER ELEVATION	DEPTH	ELEVATION	GEOLOGIC DESCRIPTION AND REMARKS	UNCONFINED COMPRESSION	STANDARD PENETRATION OR CASING DRIVE	
								BLOWS	ELEV.
					960				
						T.H.E. 957.93			
					950				
							Qu		
							20 Shelby 1		951.93
							1.1 Shelby 2		946.93
					940				
				19°	938.4				
						Ss - tan - wtd - poorly cemented Hard, brown, concretionary nodules			
				24°	933.13		27.6 Sa 1		933.5
					930	Sandstone - tan to tan/gray - hard Shale lenses, firm, gray	91.6 Sa 2		931.4
							96.9 Sa 3		929.2
							79.2 Sa 4		928.6
							117.0 Sa 5		926.3
					923.23		86.9 Sa 6		924.7
					920	Shale - gray, firm, sandy Ss stringers, hard, gray, fine wavy bedded	30.9 Sa 7		921.7
							45.9 Sa 8		919.8
				42.3	915.63		15.0 Sa 9		917.2
						Sh - gray, limy, hard	30.0 Sa 10		914.5
				44.4	913.33				
				45.2	912.63	Ls, gray, hard, fossiliferous T.D. 912.63	507.1 Sa 11		912.7
					910				

Pushed 4" casing

Mantle

White Cloud Member

"N" Core Barrel

5/30/90

Proj = 70-89 K-2446-01
 Fairbairn Road over I-70
 Bct # 10.71

DL	+	H1	-	Elev.	
ERC = 29A				979.98	Sta 9+84, 19 ⁵ L+Q Fairbairn Rd
T.	0.35	980.33			
CC = 1A			22.40	957.93	Sta 10+72, 59 L+ 2 Fairbairn Rd
					Sta 79+83, 111 L+ 2 I-70
					Sta 49+46, 59 R+ 3 Fairbairn Rd

CC = 1A	957.93	0° - 4°	Silty Clay, dk brown, soft, moist
	953.93	4° - 6°	Shelby Tube #1
	951.93	6° - 9°	Silty Clay, dk brown to brown/black, soft, moist
	948.93	9° - 11°	Shelby Tube #2

* Shelby Tubes Taken Through 8" Hollow Stem Auger

Casing	1	3 ⁸	3 ⁸
	2	7 ¹	10 ⁹
	3	7 ⁰	17 ⁹
	4	3 ⁰	20 ⁹
		- 1 ¹	19 ⁵

* Drive Casing to seal only
 19³ - 19⁴ = 7 BPT
 19⁴ - 19⁵ = 9 BPT

938.43 19⁵ - 19⁶ Ss, w/ thd, tan to brown, firm -
 * Returned cuttings, hard, brown, sharp from concretions in ss. (see Core #1)

938.33 19⁶ - 19⁸ Ss, w/ thd, tan to brown, firm to hard
 * Returned cuttings, hard, brown, sharp from concretions in ss. (see Core #1)

* Ss contact - 938.4 - Casing reached resistance and presence of cuttings like those found in Core #1

K-2406-01 Br #1071

Circ #1 239.13 19²-23² Lost *

Cut 1⁰ 234.75 23²-24⁰ Ss, tan, w/htd, soft, fine gravel
 Rec 1⁰ Tan hollow, concretions, nodules from 25²-28⁰

RQD 1⁰ = X
 2⁰-20⁰ Ss crumbles between fingers
 * 9²-23² lost due to large amount of frags that fell in hole See top Circ #1 Box #1

Sa #1 23⁰-24⁰

Circ #2 233.13 24⁰-25⁰ Lost *

Cut 2⁵ 232.13 25⁰-27³ Ss - tan/gray, firm to hard
 Rec 1⁵ A few soft, gray, sh. lenses

RQD 1⁵ = X 230.73 27²-27³ Lost *

24⁰-27³

Sa #2 26⁰-26⁵

Circ #3 230.63 27³-27⁴ Lost

Cut 3⁷ 230.53 27⁴-28⁹ Ss - hard, tan/gray
 Rec 3⁵ Some hard H gray, some concretions to 28⁹
 Few gray, soft sh. lenses

RQD 0⁰ 0⁰ = 32% 229.03 28⁹-30⁹ Ss hard, gray

27³-31⁰ Some gray, soft sh. lenses

Sa #3 28⁴-28⁷ No concretions

Sa #4 28²-29³

227.03 30⁰-31⁰ Lost

Circ #4 226.93 31⁰-31⁰ Ss - hrd, tan/gray

Cut 1³ 226.53 31⁰-31⁷ Ss - tan/gray, hard
 Rec 1³ Some gray, soft sh. lenses

RQD 1³ = 100% 226.23 31⁷-32¹ Ss - tan, hard
 Some gray, soft sh. lenses

31⁰-32³

Sa #5 31⁰-31⁶ Ss - gray, hard, limy?
 Some gray, soft sh. lenses

Core #5	20	925.63	32 ³ -33 ³	ss. tan, firm, hard
Cut 5 ^o				few soft gray ss lenses
Rec 5 ^o		925.23	32 ³ -32 ⁸	ss ls? tan hard
ROD	112 ^o = 92%	925.13	32 ³ -34 ³	ss tan, hard
32 ³ -37 ³				v few soft gray sh lenses
Sa # 6	32 ³ -33 ³	925.33	34 ³ -37 ³	sh gray, v firm, v sandy, ss stringers, tan
Sa # 7	35 ³ -36 ³			hard, wavy bedded
Core #6		920.63	37 ³ -41 ³	sh gray, firm, sandy, ss stringers tan
Cut 5 ^o				hard, wavy bedded
Rec 5 ^o				* More ss between 39 ³ -39 ^o
ROD	111 ^o D ⁹ = 76%	915.63	41 ³ -42 ³	SL sandy, firm, broken
37 ³ -42 ³				
Sa # 7	37 ³ -38 ³			1/2 ss
Sa # 9	40 ³ -40 ⁷			1/2 ss
Core #7		915.63	42 ³ -43 ³	sh gray, limy, hard
Cut 3 ^o		914.53	43 ³ -43 ³	Conglomerate, tan to gray
Rec 3 ^o		914.33	43 ³ -44 ³	sh dk gray, hard
ROD	111 ^o = 97%			fossiliferous from 44 ³
42 ³ -45 ³		913.33	44 ³ -45 ³	ls, gray, hard, fossiliferous
Sa # 10	43 ³ -43 ³	912.63	45 ³	SIS
Sa # 11	44 ³ -45 ³			

FD-89-K-2746-01

Shawnee Co

Fairlawn Rd over I-70

Sta 78+83, III' Lt of mainline

Core No. 1

Depth: 19² to 24⁸

Elevation: 938.13 to 933.13

Cut: 5°

Recovered: 1⁶

RQD: N/A

Core No. 2

Depth: 24⁸ to 27³

Elevation: 933.13 to 930.63

Cut: 2⁵Recv: 1⁵

RQD: N/A

Core No. 3

Depth: 27³ to 31°

Elevation: 930.63 to 926.93

Cut: 3⁷Recv: 3⁵

RQD: 32%

Core No. 4

Depth: 31° to 32⁹

Elevation: 926.93 to 925.63

Cut: 1³Recv: 1³

RQD: 100%

May 1990

70-89-K-2446-01

Shawnee Co

Fairlawn Rd over I-70

Sta 78+83, 111' Lt of Mainline

Core No: 5

Depth: 32³ to 37³

Elevation: 925.63 to 920.63

Cut: 5°

Recv: 5°

RQD: 88%

Core No: 6

Depth: 37³ to 42³

Elevation: 920.63 to 915.63

Cut: 5°

Recv: 5°

RQD: 76%

Core No: 7

Depth: 42³ to 45³

Elevation: 915.63 to 912.63


Cut: 3°

Recv: 3°

RQD: 97%

BRIDGE FOUNDATION GEOLOGY REPORT

Duplicate

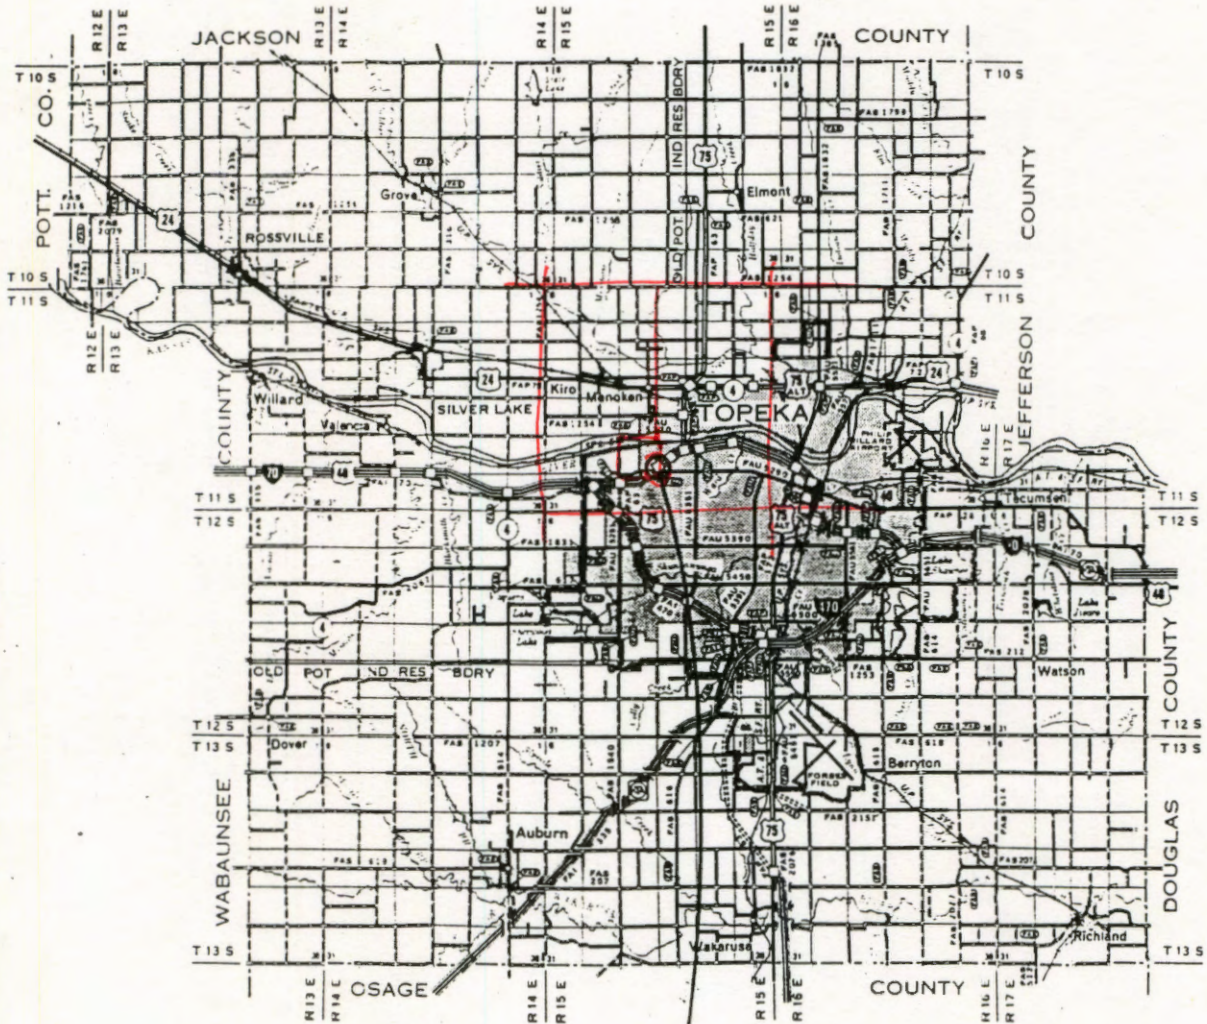

LEGEND

ROADS AND ROADWAY FEATURES		ROAD SYSTEM DESIGNATION	
PRIMITIVE ROAD	FEDERAL AID INTERSTATE HIGHWAY SYSTEM	=====
UNIMPROVED ROAD	FEDERAL AID PRIMARY HIGHWAY SYSTEM	=====
GRAVEL AND DRAINED ROAD	FEDERAL AID SECONDARY HIGHWAY SYSTEM	=====
SOIL SURFACE ROAD	INTERSTATE NUMBERED HIGHWAY	=====
GRAVEL OR STONE ROAD	U.S. NUMBERED HIGHWAY	=====
NOT GRAVEL OR DRAINED	STATE HIGHWAY SYSTEM OR	=====
GRAVEL OR STONE ROAD	STATE NUMBERED HIGHWAY	=====
GRAVEL AND DRAINED	END OF DESIGNATED SYSTEM OR	=====
GRAVEL OR STONE ROAD WITH	NAMED ROUTE	=====
STABILIZED SURFACE		
BITUMINOUS ROAD/LOW TYPE		
PAVED ROAD		
DRAINED HIGHWAY		
HIGHWAY WITH FULL CONTROL OF		
ACCESS AND INTERCHANGE		



GENERAL HIGHWAY MAP
SHAWNEE COUNTY
 KANSAS

PREPARED BY THE
 KANSAS DEPARTMENT OF TRANSPORTATION
 BUREAU OF TRANSPORTATION PLANNING

SCALE
 1:50,000

PA SYSTEM REVISED TO MAR. 15, 1966

SE-28-1W-1SE

6-45

Wabaunsee

white cloud member

70-89-K-2446-01

Br.No. 70-89-10.71
 FAIRLAWN ROAD over I-70