

County: Shawnee Fraction SW SW NW NW Sec. 22 T 11 S R 15 EW

CORRECTION(S) TO WATER WELL COMPLETION RECORD (WWC-5)
(to rectify lacking or incorrect information)

Owner: Ed I Clare

Location was listed as:

Section-Township-Range: None Given

Fraction ($\frac{1}{4}$ $\frac{1}{4}$ $\frac{1}{4}$): _____

Location changed to:

22-11S-15E

SW SW NW NW

Other changes: Initial statements: _____

Changed to: _____

Comments: _____

Verification method: Latitude & longitude, KGS' "LEO" conversion tool,
written description, and mapping tool & aerial photos on
KGS website. initials: DR date: 11/26/2013

Submitted by: Kansas Geological Survey, Data Resources Library, 1930 Constant Ave., Lawrence, KS 66047-3726
to: Kansas Dept of Health & Environment, Bureau of Water, 1000 SW Jackson, Suite 420, Topeka, KS 66612-1367.

WATER WELL RECORD

Form WWC-5


Division of Water Resources App. No.

1 LOCATION OF WATER WELL: County: Shawnee	Fraction $\frac{1}{4}$ $\frac{1}{4}$ $\frac{1}{4}$ $\frac{1}{4}$	Section Number	Township No. T S R	Range Number R <input type="checkbox"/> E <input type="checkbox"/> W
--	---	----------------	---------------------------	---

Street/Rural Address of Well Location; if unknown, distance & direction from nearest town or intersection: If at owner's address, check here .
SE Corner of Menoken Rd and 24 HWY - 400 Yards

Global Positioning System (GPS) information:
 Latitude: **39.08460** (in decimal degrees)
 Longitude: **095.74307** (in decimal degrees)
 Elevation: **848**
 Datum: WGS 84, NAD 83, NAD 27
 Collection Method:
 GPS unit (Make/Model: **Garmin 60CSX**)
 Digital Map/Photo, Topographic Map, Land Survey
 Est. Accuracy: <3 m, 3-5 m, 5-15 m, >15 m

2 WATER WELL OWNER: Ed I Clare
 RR#, Street Address, Box #: **3868 114th Street**
 City, State, ZIP Code : **Meriden KS 66512**

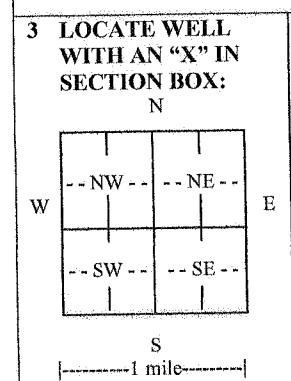

4 DEPTH OF COMPLETED WELL **51.8** ft.

Depth(s) Groundwater Encountered (1) **21.5** ft. (2)..... ft. (3)..... ft.
 WELL'S STATIC WATER LEVEL **21.5** ft. below land surface measured on mo/day/yr. **06/20/13**
 Pump test data: Well water was **36.3** ft. after **6** hours pumping. **1200** gpm
 EST. YIELD **1200** gpm. Well water was..... ft. after..... hours pumping..... gpm
 Bore Hole Diameter **36** in. to **51.8** ft., and..... in. to..... ft.
 WELL WATER TO BE USED AS: Public water supply Geothermal Injection well
 Domestic Feedlot Oil field water supply Dewatering Other (Specify below)
 Irrigation Industrial Domestic-lawn & garden Monitoring well
 Was a chemical/bacteriological sample submitted to Department? Yes No
 If yes, mo/day/yr sample was submitted.....
 Water well disinfected? Yes No

5 TYPE OF CASING USED: Steel PVC Other
 CASING JOINTS: Glued Clamped Welded Threaded
 Casing diameter **16** in. to **51.8** ft., Diameter..... in. to..... ft., Diameter..... in. to..... ft.
 Casing height above land surface **12** in., Weight..... lbs./ft., Wall thickness or gauge No. **SDR 26**
 TYPE OF SCREEN OR PERFORATION MATERIAL:
 Steel Stainless Steel PVC Other (Specify).....
 Brass Galvanized Steel None used (open hole)
 SCREEN OR PERFORATION OPENINGS ARE:
 Continuous slot Mill slot Gauze wrapped Torch cut Drilled holes None (open hole)
 Louvered shutter Key punched Wire wrapped Saw cut Other (specify).....
 SCREEN-PERFORATED INTERVALS: From **31.8** ft. to **51.8** ft., From..... ft. to..... ft.
 GRAVEL PACK INTERVALS: From **20** ft. to **51.8** ft., From..... ft. to..... ft.
 From..... ft. to..... ft., From..... ft. to..... ft.

6 GROUT MATERIAL: Neat cement Cement grout Bentonite Other
 Grout Intervals: From **0** ft. to **20** ft., From..... ft. to..... ft., From..... ft. to..... ft.
 What is the nearest source of possible contamination:
 Septic tank Lateral lines Pit privy Livestock pens Insecticide storage Other (specify below)
 Sewer lines Cesspool Sewage lagoon Fuel storage Abandoned water well **NONE**
 Watertight sewer lines Seepage pit Feedyard Fertilizer storage Oil well/gas well
 Direction from well..... Distance from well.....

FROM	TO	LITHOLOGIC LOG	FROM	TO	LITHO. LOG (cont.) or PLUGGING INTERVALS
0	5'	Top Soil and Fine Sand	50'	51.8	Coarse Sand to Shale
5'	10'	Fine Sand and Clay			
10'	15'	Fine Sand			
15'	20'	Fine Sand			
20'	25'	Fine Sand - Medium Sand			
25'	30'	Fine Sand - Medium Sand			
30'	35'	Fine Sand - Coarse Sand			
35'	40'	Medium Sand to Coarse Sand			
40'	45'	Medium Sand to Coarse Sand			
45'	50'	Coarse Sand			

7 CONTRACTOR'S OR LANDOWNER'S CERTIFICATION: This water well was constructed, reconstructed, or plugged under my jurisdiction and was completed on (mo/day/year) **06/20/13** and this record is true to the best of my knowledge and belief. Kansas Water Well Contractor's License No. **631**. This Water Well Record was completed on (mo/day/year) **11/10/2013** under the business name of **Alexander Pump & Services, Inc.** by (signature) *[Signature]*

INSTRUCTIONS: Use typewriter or ball point pen. *PLEASE PRESS FIRMLY* and *PRINT* clearly. Please fill in blanks and check the correct answers. Send one copy to Kansas Department of Health and Environment, Bureau of Water, Geology Section, 1000 SW Jackson St., Suite 420, Topeka, Kansas 66612-1367. Telephone 785-296-5524. Send one copy to WATER WELL OWNER and retain one for your records. Include fee of \$5.00 for each constructed well. Visit us at <http://www.kdheks.gov/waterwell/index.html>