

County: Shawnee Fraction SW-NE-SW-NE Sec. 15 T 11 S R 15 Q/W

CORRECTION(S) TO WATER WELL COMPLETION RECORD (WWC-5)

(to rectify lacking or incorrect information)

Owner: Wolfe, Randy

Location was listed as:

Section-Township-Range: None

Fraction (1/4 1/4 1/4): None

Location changed to:

15-11S-15E

SW-NE-SW-NE

Other changes: Initial statements: _____

Changed to: _____

Comments: _____

Verification method: Mapped Lat/Long, Found Well Constructed Form in WWC5 Database

initials: DF date: 5/6/14

Submitted by: Kansas Geological Survey, Data Resources Library, 1930 Constant Ave., Lawrence, KS 66047-3726
to: Kansas Dept of Health & Environment, Bureau of Water, 1000 SW Jackson, Suite 420, Topeka, KS 66612-1367.

WATER WELL RECORD


Form WWC-5

Division of Water Resources App. No.

1 LOCATION OF WATER WELL: County: Shawnee Fraction 1/4 1/4 1/4 1/4 Section Number Township No. T S Range Number R E W

Street/Rural Address of Well Location; if unknown, distance & direction from nearest town or intersection: If at owner's address, check here [] Global Positioning System (GPS) information: Latitude: 39.10033 Longitude: 095.73098 Elevation: 920 Datum: [] WGS 84, [] NAD 83, [] NAD 27 Collection Method: [x] GPS unit (Make/Model: Garmin 60CSX) [] Digital Map/Photo, [] Topographic Map, [] Land Survey Est. Accuracy: [] <3 m, [] 3-5 m, [] 5-15 m, [] >15 m

2 WATER WELL OWNER: Randy Wolfe RR#, Street Address, Box #: 5348 NW Valencia RD City, State, ZIP Code : Silver Lake, Kansas 66539

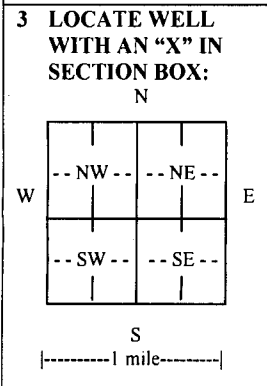

3 LOCATE WELL WITH AN 'X' IN SECTION BOX: 4 DEPTH OF COMPLETED WELL 52' ft. Depth(s) Groundwater Encountered (1)..... ft. (2)..... ft. (3)..... ft. WELL'S STATIC WATER LEVEL 22' ft. below land surface measured on mo/day/yr..... Pump test data: Well water was..... ft. after..... hours pumping..... gpm EST. YIELD..... gpm. Well water was..... ft. after..... hours pumping..... gpm Bore Hole Diameter in. to ft., and in. to ft. WELL WATER TO BE USED AS: [] Public water supply [] Geothermal [] Injection well [] Domestic [] Feedlot [] Oil field water supply [] Dewatering [] Other (Specify below) [x] Irrigation [] Industrial [] Domestic-lawn & garden [] Monitoring well Was a chemical/bacteriological sample submitted to Department? [] Yes [x] No If yes, mo/day/yr sample was submitted..... Water well disinfected? [x] Yes [] No

5 TYPE OF CASING USED: [] Steel [x] PVC [] Other CASING JOINTS: [] Glued [] Clamped [] Welded [x] Threaded Casing diameter .16 in. to .52 ft., Diameter in. to ft. Casing height above land surface .12 in., Weight lbs./ft., Wall thickness or gauge No. SDR26 TYPE OF SCREEN OR PERFORATION MATERIAL: [] Steel [] Stainless Steel [x] PVC [] Other (Specify) [] Brass [] Galvanized Steel [] None used (open hole) SCREEN OR PERFORATION OPENINGS ARE: [] Continuous slot [x] Mill slot [] Gauze wrapped [] Torch cut [] Drilled holes [] None (open hole) [] Louvered shutter [] Key punched [] Wire wrapped [] Saw cut [] Other (specify) SCREEN-PERFORATED INTERVALS: From .52' ft. to .32' ft., From ft. to ft. GRAVEL PACK INTERVALS: From .52' ft. to .20' ft., From ft. to ft. From ft. to ft., From ft. to ft.

6 GROUT MATERIAL: [] Neat cement [] Cement grout [x] Bentonite [] Other Grout Intervals: From .20' ft. to .0' ft., From ft. to ft., From ft. to ft. What is the nearest source of possible contamination: [] Septic tank [] Lateral lines [] Pit privy [] Livestock pens [] Insecticide storage [x] Other (specify below) [] Sewer lines [] Cesspool [] Sewage lagoon [] Fuel storage [] Abandoned water well [] Watertight sewer lines [] Seepage pit [] Feedyard [] Fertilizer storage [] Oil well/gas well none Direction from well Distance from well

Table with 6 columns: FROM, TO, LITHOLOGIC LOG, FROM, TO, LITHO. LOG (cont.) or PLUGGING INTERVALS. The table is currently empty.

7 CONTRACTOR'S OR LANDOWNER'S CERTIFICATION: This water well was [] constructed, [x] reconstructed, or [] plugged under my jurisdiction and was completed on (mo/day/year) 04/10/14 and this record is true to the best of my knowledge and belief. Kansas Water Well Contractor's License No. 631. This Water Well Record was completed on (mo/day/year) 04/22/2014 under the business name of Alexander Pump & Services, Inc. by (signature) Terry Alexander

INSTRUCTIONS: Use typewriter or ball point pen. PLEASE PRESS FIRMLY and PRINT clearly. Please fill in blanks and check the correct answers. Send one copy to Kansas Department of Health and Environment, Bureau of Water, Geology Section, 1000 SW Jackson St., Suite 420, Topeka, Kansas 66612-1367. Telephone 785-296-5524. Send one copy to WATER WELL OWNER and retain one for your records. Include fee of \$5.00 for each constructed well. Visit us at http://www.kdheks.gov/waterwell/index.html