

County: Shawnee Fraction SW NE SE NW Sec. 24 T 11 S R 15 EW

CORRECTION(S) TO WATER WELL COMPLETION RECORD (WWC-5)

(to rectify lacking or incorrect information)

Owner: Peter Meier

Location was listed as:

Section-Township-Range: None Given

Fraction (1/4 1/4 1/4): _____

Location changed to:

24-11S-15E

SW NE SE NW

Other changes: Initial statements: _____

Changed to: _____

Comments: _____

Verification method: Latitude & Longitude, KGS' "LEO" conversion tool,
Water rights information in WIMAS database, and mapping tool
& aerial photos on KGS website. initials: DRL date: 6/10/2014

Submitted by: Kansas Geological Survey, Data Resources Library, 1930 Constant Ave., Lawrence, KS 66047-3726

to: Kansas Dept of Health & Environment, Bureau of Water, 1000 SW Jackson, Suite 420, Topeka, KS 66612-1367.

WATER WELL RECORD

Form WWC-5


Division of Water Resources App. No.

1 LOCATION OF WATER WELL: County: <u>Shawnee</u>	Fraction $\frac{1}{4}$ $\frac{1}{4}$ $\frac{1}{4}$ $\frac{1}{4}$	Section Number	Township No. T S R	Range Number <input type="checkbox"/> E <input type="checkbox"/> W
--	---	----------------	---------------------------	---

Street/Rural Address of Well Location; if unknown, distance & direction from nearest town or intersection: If at owner's address, check here

Global Positioning System (GPS) information:
 Latitude: .39.08274..... (in decimal degrees)
 Longitude: 095.69884..... (in decimal degrees)
 Elevation: 899.....
 Datum: WGS 84, NAD 83, NAD 27
 Collection Method:
 GPS unit (Make/Model: Garmin 60CSX.....)
 Digital Map/Photo, Topographic Map, Land Survey
 Est. Accuracy: <3 m, 3-5 m, 5-15 m, >15 m

2 WATER WELL OWNER: Peter Meier
 RR#, Street Address, Box #: 2300 NW Lower Silver Lake Rd
 City, State, ZIP Code : Topeka, Kansas 66618

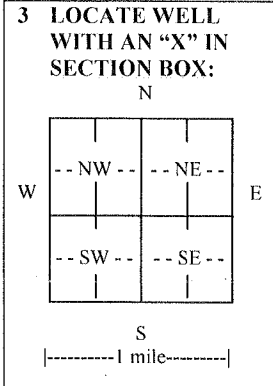

4 DEPTH OF COMPLETED WELL 52..... ft.
 Depth(s) Groundwater Encountered (1) 24..... ft. (2)..... ft. (3)..... ft.
 WELL'S STATIC WATER LEVEL 24..... ft. below land surface measured on mo/day/yr. 03/06/14.....
 Pump test data: Well water was 40'.....ft. after 6..... hours pumping. 500..... gpm
 EST. YIELD.....gpm. Well water was.....ft. after..... hours pumping..... gpm
 Bore Hole Diameter 36.....in. to 52.....ft., andin. toft.
 WELL WATER TO BE USED AS: Public water supply Geothermal Injection well
 Domestic Feedlot Oil field water supply Dewatering Other (Specify below)
 Irrigation Industrial Domestic-lawn & garden Monitoring well
 Was a chemical/bacteriological sample submitted to Department? Yes No
 If yes, mo/day/yr sample was submitted.....
 Water well disinfected? Yes No

5 TYPE OF CASING USED: Steel PVC Other

CASING JOINTS: Glued Clamped Welded Threaded
 Casing diameter 16..... in. to 52..... ft., Diameter in. to ft., Diameter in. to ft.
 Casing height above land surface 12..... in., Weightlbs./ft., Wall thickness or gauge No. SDR26.....
 TYPE OF SCREEN OR PERFORATION MATERIAL:
 Steel Stainless Steel PVC Other (Specify)
 Brass Galvanized Steel None used (open hole)
 SCREEN OR PERFORATION OPENINGS ARE:
 Continuous slot Mill slot Gauze wrapped Torch cut Drilled holes None (open hole)
 Louvered shutter Key punched Wire wrapped Saw cut Other (specify)
 SCREEN-PERFORATED INTERVALS: From 32..... ft. to 52..... ft., From ft. to ft.
 From ft. to ft., From ft. to ft.
 GRAVEL PACK INTERVALS: From 20'..... ft. to 52..... ft., From ft. to ft.
 From ft. to ft., From ft. to ft.

6 GROUT MATERIAL: Neat cement Cement grout Bentonite Other

Grout Intervals: From 0'..... ft. to 20'..... ft., From ft. to ft., From ft. to ft.
 What is the nearest source of possible contamination:
 Septic tank Lateral lines Pit privy Livestock pens Insecticide storage Other (specify below)
 Sewer lines Cesspool Sewage lagoon Fuel storage Abandoned water well
 Watertight sewer lines Seepage pit Feedyard Fertilizer storage Oil well/gas well none.....
 Direction from well Distance from well

FROM	TO	LITHOLOGIC LOG	FROM	TO	LITHO. LOG (cont.) or PLUGGING INTERVALS
0'	5'	Top Soil and Fine Sand			
5'	10'	Fine Sand			
10'	15'	Fine Sand			
15'	20'	Fine Sand			
20'	25'	Fine Sand - Medium Sand			
25'	30'	Fine Sand - Medium Sand			
30'	35'	Fine Sand - Medium Sand			
35'	40'	Medium Sand			
40'	45'	Medium Sand			
45'	52'	Medium Sand to Shale			

7 CONTRACTOR'S OR LANDOWNER'S CERTIFICATION: This water well was constructed, reconstructed, or plugged under my jurisdiction and was completed on (mo/day/year) 03/06/2014..... and this record is true to the best of my knowledge and belief. Kansas Water Well Contractor's License No. 631..... This Water Well Record was completed on (mo/day/year) 04/21/2014..... under the business name of Alexander Pump & Services, Inc...... by (signature) Jeremy Alexander.....

INSTRUCTIONS: Use typewriter or ball point pen. PLEASE PRESS FIRMLY and PRINT clearly. Please fill in blanks and check the correct answers. Send one copy to Kansas Department of Health and Environment, Bureau of Water, Geology Section, 1000 SW Jackson St., Suite 420, Topeka, Kansas 66612-1367. Telephone 785-296-5524. Send one copy to WATER WELL OWNER and retain one for your records. Include fee of \$5.00 for each constructed well. Visit us at <http://www.kdbeks.gov/waterwell/index.html>