

County: Shawnee Fraction: _____ Sec. 16 T 11 S R 15 0 B/W

CORRECTION(S) TO WATER WELL COMPLETION RECORD (WWC-5)

(To rectify lacking or incorrect information)

Owner: KDOT

Location was listed as:

~~Section-Township-Range:~~ _____

~~Fraction ($\frac{1}{4}$ $\frac{1}{4}$ $\frac{1}{4}$):~~ _____

Changed to:

Other changes: Initial statements: _____

Station # 143 + 98.5, 64' RT & US-24

Changed to: _____

Comments: _____


KDOT core available for CD 2 also
(no paperwork as of 12/10/2015)

Verification method: _____

initials: CN date: 12/10/2015

Submitted by: Kansas Geological Survey, Data Resources Library, 1930 Constant Ave., Lawrence KS 66047-3726

to: Kansas Dept of Health & Environment, Bureau of Water, 1000 SW Jackson, Suite 420, Topeka, KS 66612-1367.

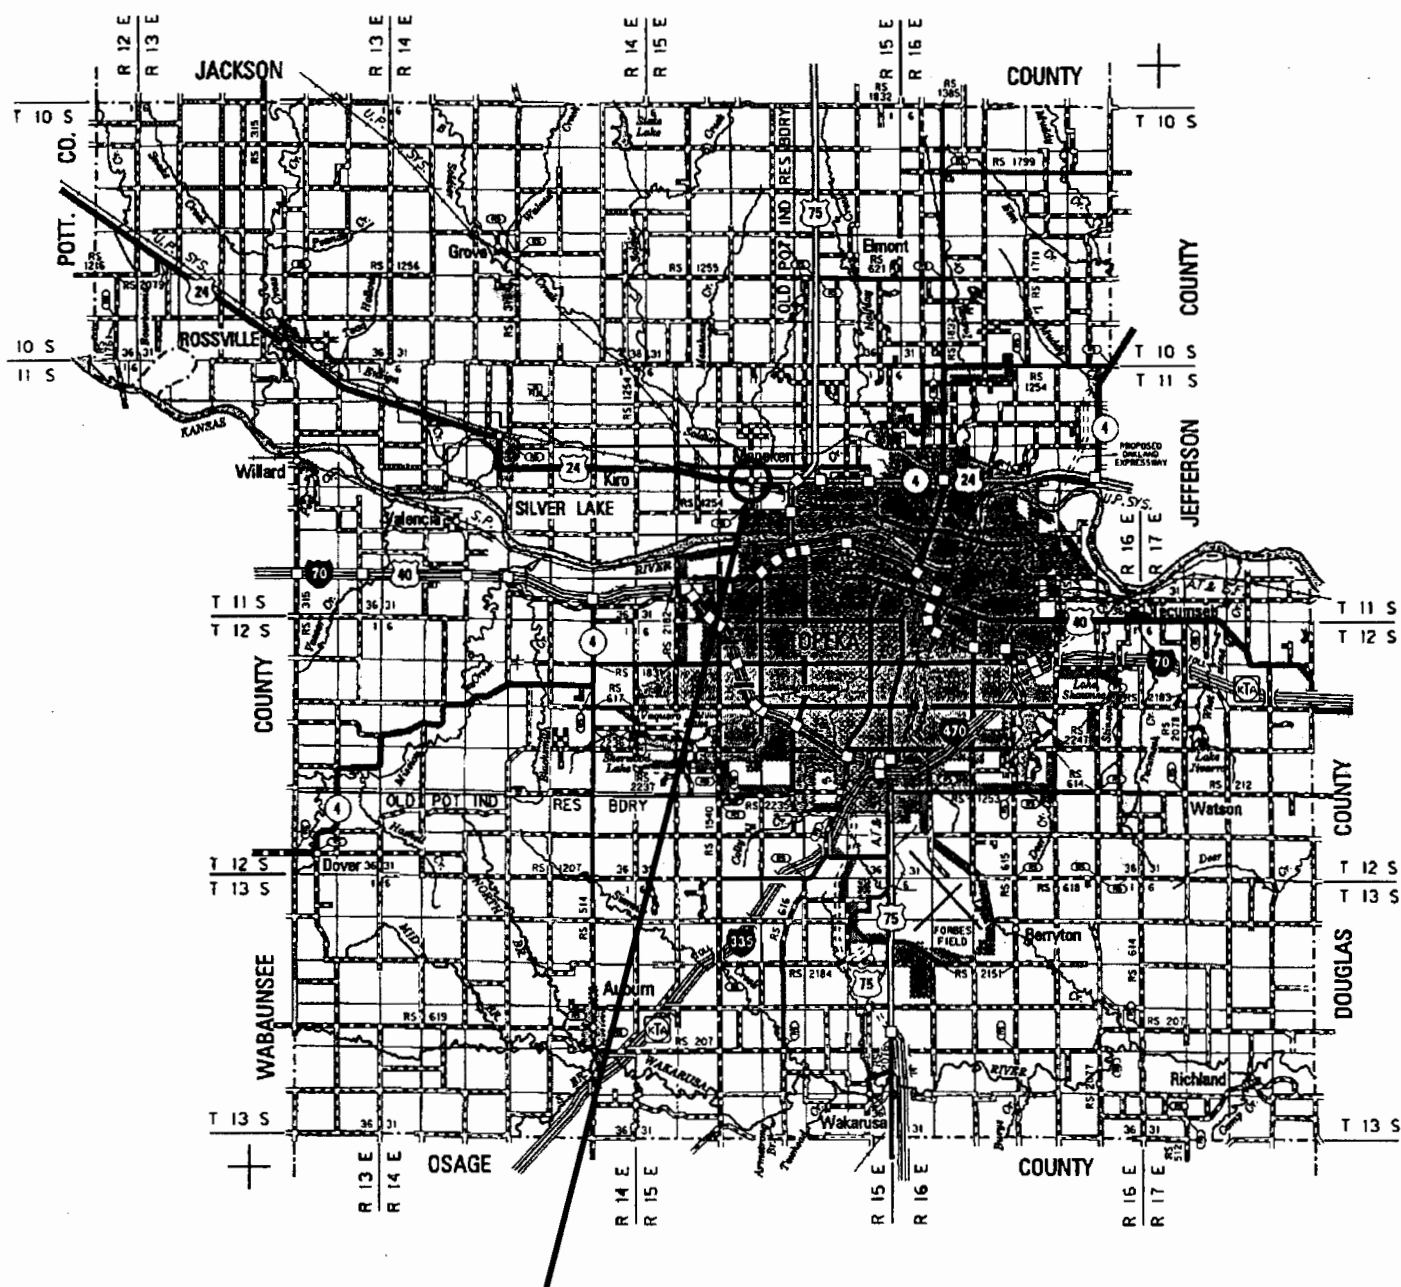

24-89 K-7431-01

EB & WB US-24 over Menoken Road

Bridge Nos. 24-89-17.67(296)WB

Shawnee County

CD 03

N:39.091597 E-95.748754 (Approx.)

SE $\frac{1}{4}$, NW $\frac{1}{4}$, SE $\frac{1}{4}$, Section 16, T11S, R15E