


Original Record Correction Change in Well Use

1 LOCATION OF WATER WELL: County: Shawnee Fraction: SW 1/4 SW 1/4 SE 1/4 SW 1/4 Section Number: 25 Township Number: T 11 S Range Number: R 15 E W

2 WELL OWNER: Last Name: EL Paso Remediation Company First: 2201 SW 6th Street or Rural Address where well is located (if unknown, distance and direction from nearest town or intersection): If at owner's address, check here:
 Business: 2 North Nevada Ave. TOPKA, KS
 Address: Colorado Springs State: CO ZIP: 80903

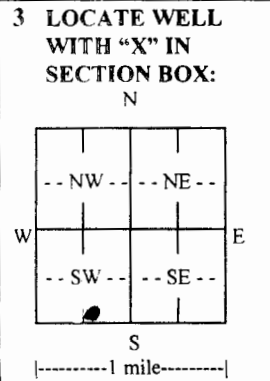

4 DEPTH OF COMPLETED WELL: 14 1/2 ft.
 Depth(s) Groundwater Encountered: 1) 5 ft.
 2) ft. 3) ft. Dry Well
 WELL'S STATIC WATER LEVEL: 6.38 ft. 5/20/16
 below land surface, measured on (mo-day-yr)
 above land surface, measured on (mo-day-yr)
 Pump test data: Well water was ft. after hours pumping gpm
 Well water was ft. after hours pumping gpm
 Estimated Yield: gpm
 Bore Hole Diameter: 7 1/2 in. to 14 1/2 ft. and in. to ft.

5 Latitude: 39. 05903 (decimal degrees)
Longitude: 95. 70100 (decimal degrees)
 Datum: WGS 84 NAD 83 NAD 27
 Source for Latitude/Longitude:
 GPS (unit make/model:)
 (WAAS enabled? Yes No)
 Land Survey Topographic Map
 Online Mapper:

6 Elevation: 922.59 ft. Ground Level TOC
 Source: Land Survey GPS Topographic Map
 Other

7 WELL WATER TO BE USED AS:

1. Domestic: Household Lawn & Garden Livestock
 2. Irrigation
 3. Feedlot
 4. Industrial

5. Public Water Supply: well ID
 6. Dewatering: how many wells?
 7. Aquifer Recharge: well ID
 8. Monitoring: well ID
 9. Environmental Remediation: well ID
 Air Sparge Soil Vapor Extraction
 Recovery Injection

10. Oil Field Water Supply: lease
 11. Test Hole: well ID
 Cased Uncased Geotechnical
 12. Geothermal: how many bores?
 a) Closed Loop Horizontal Vertical
 b) Open Loop Surface Discharge Inj. of Water
 13. Other (specify):

Was a chemical/bacteriological sample submitted to KDHE? Yes No If yes, date sample was submitted:
 Water well disinfected? Yes No

8 TYPE OF CASING USED: Steel PVC Other CASING JOINTS: Glued Clamped Welded Threaded
 Casing diameter 2.375 in. to 4 ft., Diameter in. to ft., Diameter in. to ft.
 Casing height above land surface Flush ft. Weight lbs./ft. Wall thickness or gauge 5/16 in.

TYPE OF SCREEN OR PERFORATION MATERIAL:
 Steel Stainless Steel Fiberglass PVC Other (Specify)
 Brass Galvanized Steel Concrete tile None used (open hole)

SCREEN OR PERFORATION OPENINGS ARE:
 Continuous Slot Mill Slot Gauze Wrapped Torch Cut Drilled Holes Other (Specify)
 Louvered Shutter Key Punched Wire Wrapped Saw Cut None (Open Hole)
 SCREEN-PERFORATED INTERVALS: From 14.6 ft. to 47.6 ft., From ft. to ft., From ft. to ft.
 GRAVEL PACK INTERVALS: From 14.6 ft. to 37 ft., From ft. to ft., From ft. to ft.

9 GROUT MATERIAL: Neat cement Cement grout Bentonite Other concrete
 Grout Intervals: From 3 ft. to 1 ft., From 1 ft. to 2 ft., From ft. to ft.

Nearest source of possible contamination:
 Septic Tank Lateral Lines Pit Privy Livestock Pens Insecticide Storage
 Sewer Lines Cess Pool Sewage Lagoon Fuel Storage Fueler Abandoned Water Well
 Watertight Sewer Lines Seepage Pit Feedyard Fertilizer Storage Oil Well/Gas Well
 Other (Specify)

Direction from well? South South West Distance from well? 200 ft.

10 FROM	TO	LITHOLOGIC LOG	FROM	TO	LITHO. LOG (cont.) or PLUGGING INTERVALS
0	1.0	Asphalt over sand base			
1.0	3.5	black clay			
3.5	12.0	Burley residual fill			
12.0	14 1/2	brn shaly clay w/ till			

Notes:

11 CONTRACTOR'S OR LANDOWNER'S CERTIFICATION: This water well was constructed, reconstructed, or plugged under my jurisdiction and was completed on (mo-day-year) 5/19/16 and this record is true to the best of my knowledge and belief. Kansas Water Well Contractor's License No. 732 This Water Well Record was completed on (mo-day-year) 6/1/16 under the business name of GB Environmental Drilling