




WATER WELL RECORD Form WWC-5 1348959

Division of Water Resources App. No. [] Well ID []

Original Record [] Correction [] Change in Well Use []

1 LOCATION OF WATER WELL: County: Fraction 1/4 1/4 1/4 1/4 Section Number Township Number T S Range Number R E W

2 WELL OWNER: Last Name: Business: Address: City: State: ZIP: Street or Rural Address where well is located

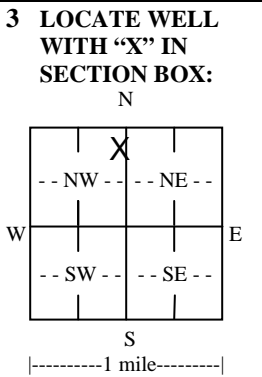

4 DEPTH OF COMPLETED WELL: Depth(s) Groundwater Encountered: 1) ... ft. 2) ... ft. 3) ... ft., or 4) [] Dry Well

5 Latitude: ... (decimal degrees) Longitude: ... (decimal degrees) Datum: [] WGS 84 [] NAD 83 [] NAD 27

6 Elevation: ... ft. [] Ground Level [] TOC Source: [] Land Survey [] GPS [] Topographic Map [] Other

7 WELL WATER TO BE USED AS: 1. Domestic: [] Household [] Lawn & Garden [] Livestock 2. Irrigation 3. Feedlot 4. Industrial

Was a chemical/bacteriological sample submitted to KDHE? [] Yes [] No If yes, date sample was submitted: Water well disinfected? [] Yes [] No

8 TYPE OF CASING USED: [] Steel [] PVC [] Other CASING JOINTS: [] Glued [] Clamped [] Welded [] Threaded

9 GROUT MATERIAL: [] Neat cement [] Cement grout [] Bentonite [] Other Nearest source of possible contamination: [] Septic Tank [] Lateral Lines [] Pit Privy

Table with 6 columns: FROM, TO, LITHOLOGIC LOG, FROM, TO, LITHO. LOG (cont.) or PLUGGING INTERVALS. Includes a Notes section.

11 CONTRACTOR'S OR LANDOWNER'S CERTIFICATION: This water well was [] constructed, [] reconstructed, or [] plugged under my jurisdiction and was completed on (mo-day-year) and this record is true to the best of my knowledge and belief.