
			WWC-5		Division of Water			W 11 TD	MW-8	
		Correction Chan			esources App. N			Well ID	- M1	
	ty: Shawne	VATER WELL:	Fraction NW NW		Section Number 36		Number		ge Number ■ E □ W	
	OWNER:		1/4 SON 1/4 SYN 1/4			where well is l				
Business Address Address	s: Mikey's (: 2219 SW	Certified Auto Care, LI 10th Avenue State: KS				intersection): If				
City:	Topeka TE WELL					0.4	0.05400			
	"X" IN	4 DEPTH OF CO	MPLETED WELL:	25	ft. 5 Latit	ude:3	9.05120	((decimal degree	
	ON BOX:	Depth(s) Groundwater	.D ft.		itude:	95.70460	((decimal degree		
2) N/A ft. 3) N/A ft., or 4) \(\text{VELL'S STATIC WATER LEVEL: 7.70} \)						ontal Datum:		NAD 8	33 LI NAD 2	
below land surface, measured on (mo-day-yr						e for Latitude/Lo PS (unit make/m				
NW-	NE	above land surfac	yr)		(WAAS enab					
		Pump test data: Well afterN/A hou	t.	L	and Survey			,		
X	E	afterN/A hou	gpm		nline Mapper:					
SW -	SE	after N/A hou	t.		***********					
1		Estimated Yield:N	gpm	6 Elevation: 541.00ft. Ground Level 1700						
	S Bore Hole Diameter: . 8.25 in. to 25									
1	mile		N/A in to N/A	ft.		Other				
WELL	WATER T	O BE USED AS:								
. Domesti	c:	5. Public W								
Hous		6. Dewater								
	& Garden	7. Aquiter I	N-8							
□ Lawn & Garden 7. □ Aquifer Recharge; well ID □ Livestock 8. ■ Monitoring; well ID □ Irrigation 9. Environmental Remediation; well ID					a) Closed Loop Horizontal Vertical					
. Feedlot Air Sparge Soil Vapor Extr					b) Open Loop Surface Discharge Inj. of Water					
☐ Industrial ☐ Recovery ☐ Injection						13. Other (specify):				
Vas a ch	emical/bacte	eriological sample sub	mitted to KDHE?	Yes N	o If yes, date	e sample was si	ubmitted:			
		? Yes No			,,					
TYPE	OF CASING	G USED: Steel P	VC Other	CA	SING JOINTS	: Glued G	Clamped [Welded	Threaded	
Casing dias	meter2	in. to 15 ft surface 0	, Diameter N/A	in. to!	V/A ft., Dian	neter N/A	in. to	/A ft.		
asing heigh	ght above land	surface 0	n. Weight N/A	lbs./1	t. Wall thick	mess or gauge N	o. Sch.40)		
		R PERFORATION MA								
☐ Steel	_	inless Steel Fibe		1 (1		ner (Specify)	• • • • • • • • • • • • •		**********	
☐ Brass		Ivanized Steel		sed (open h	iole)					
	inuous Slot			rch Cut F	Drilled Holes	☐ Other (Spec	rify)			
☐ Louv	vered Shutter	☐ Key Punched ☐ \	Wire Wrapped Sa	w Cut	None (Open H	(ole)				
CREEN-	PERFORAT	TED INTERVALS: Fro	m .15 ft. to 25	ft., From	n .N/A ft. to	N/A ft., F	rom N/A	ft. to	N/A ft.	
(GRAVEL PA	CK INTERVALS: Fro	m 13 ft. to 25	ft., From	n N/A ft. t	N/A ft., F	rom N/A	A ft. to	N/A ft.	
GROU	T MATERI	AL: Neat cement [2 ft. to .13	Cement grout Be	entonite	Other Concr	ete 0 to 2 feet				
rout Inter	vals: From .		ft., From .N/A	ft. toN	(A ft., From	N/A ft. to	D N/A	ft.		
Seption		ole contamination: Lateral Lin	es		☐ Livestock Pe		Insecticide	Chamana		
☐ Sewer		Cess Pool	Sewage La		Fuel Storage		Abandone		Well	
	rtight Sewer L				☐ Fertilizer Sto		Oil Well/C		VOII	
Other	(Specify)	outh				_				
irection fi	rom well? .S	outh	Distance from w							
0 FROM		LITHOLO	GIC LOG	FROM		LITHO. LOG (
	1	Fill		1		intermixed bla				
	7	SILT clayey moist gre				SILT sandy ta				
	10	SILT clayey grades in		15		SILT clayey n	noist grey	black p	plastic wet a	
		grey to tan w/orange		200		18-feet				
		plastic slightly moist	imestone gravei	20	25	CLAY				
1	12	intermixed @ 8-9'	arted moiet	Mada						
2	12		and tan-grey well sorted moist Notes:							
-	14 SILT clayey some sand plastic grey with orange mottling some limestone fragment									
1 CONT	FRACTOP:	S OR LANDOWNER			ter well was	constructed	Trecore	tructed	or nlugge	
inder my	iurisdiction	and was completed on (mo-day-year) 12-11-	2017 at	nd this record	is true to the be	st of my l	cnowlede	ze and belief	
ansas W	ater Well Co	ontractor's License No.	759 This Wa	ater Well F	Record was con	npleted on mo	day-year) 1-13-	8	
nder the	business nan	ontractor's License No. ne of RAZEK Environ	mental, LLC		SignatureQ	a frake	S	P		
Mai	l I white copy a	long with a fee of \$5.00 for ea	ach constructed well to: Kar	sas Departm	ent of Health and	Environment, Bur	eau of Water	r, GWTS S	ection,	
		St., Suite 420, Topeka, Kansa	s 66612-1367. Mail one to			ne for your records				
visit us at ht	tp://www.kdhel	ks.gov/waterwell/index.html		KSA 82a-	1212			Kevised	7/10/2015	

SHAWNEE CO

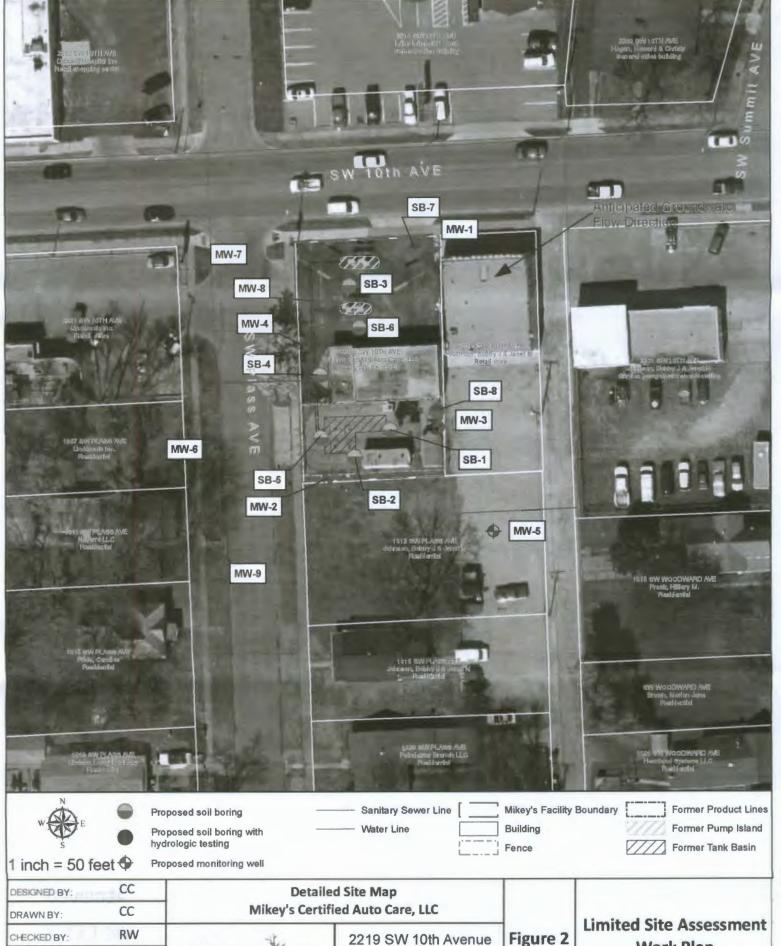

CC APPROVED BY: OCTOBER 2017 DATE

ppB EnviroSolutions professional | practical | below-ground

Topeka, KS U4-089-14937 Figure 2

Work Plan