

## WATER WELL PLUGGING RECORD Form WWC-5P

KSA 82a-1212

ID NO.

MW1

**1 LOCATION OF WATER WELL:** Fraction NW 1/4 NW 1/4 SE 1/4 SE 1/4 Section Number 32 Township Number T 11 S Range Number 15 ☒ E ☐ W  
 County: Shawnee

Street/Rural Address of Well Location: if unknown, distance & direction from nearest town or intersection: If at owner's address, check here ☒ 1149 SW Winding Rd.  
Topeka, KS 66615

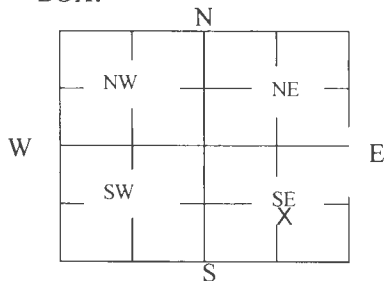
**Global Positioning Systems (GPS) information:**Latitude: 39.046363 (in decimal degrees)Longitude: 95.766470 (in decimal degrees)

Elevation: \_\_\_\_\_

Horizontal Datum: ☒ WGS84, ☐ NAD83, ☐ NAD27

Collection Method: \_\_\_\_\_

**2 WATER WELL OWNER:** Berry Companies, Inc.  
 RR#, St. Address, Box #: 1149 SW Winding Rd.  
 City, State ZIP Code: Topeka, KS 66615

☒ GPS unit (Make/Model: Garmen etrek)☐ Digital Map/Photo, ☐ Topographic Map, ☐ Land SurveyEst. Accuracy: ☒ < 3 m, ☐ 3-5 m, ☐ 5-15 m, ☐ > 15 m**3 MARK WELL'S LOCATION WITH AN "X" IN SECTION BOX:****4 DEPTH OF WELL** 19.64 ft.WELL'S STATIC WATER LEVEL 17.04 ft

WELL WAS USED AS:

☐ Domestic  
☐ Irrigation  
☐ Feedlot  
☐ Industrial

☐ Public Water Supply  
☐ Oil Field Water Supply  
☐ Domestic (Lawn & Garden)  
☐ Air Conditioning

☐ Dewatering  
☒ Monitoring  
☐ Injection Well  
☐ Other \_\_\_\_\_
Was a chemical/bacteriological sample submitted to Department? Yes ☐ No ☒**5 TYPE OF BLANK CASING USED:**☐ Steel  
☒ PVC☐ RMP (SR)  
☐ ABS☐ Wrought  
☐ Asbestos-Cement☐ Fiberglass  
☐ Concrete Tile☐ Other (Specify below) \_\_\_\_\_

Blank casing diameter 2 in. Was casing pulled? Yes ☒ No ☐ If yes, how much 3'  
 Casing height above or below land surface \_\_\_\_\_ in.

**6 GROUT PLUG MATERIAL:** ☐ Neat cement ☐ Cement grout ☒ Bentonite ☒ Other AsphaltGrout Plug Intervals: From 19.64 ft. to 0.5 ft., From 0.5 ft. to 0 ft., From \_\_\_\_\_ ft. to \_\_\_\_\_ ft.

What is the nearest source of possible contamination:

☐ Septic tank  
☐ Sewer lines  
☐ Watertight sewer lines  
☐ Lateral lines  
☐ Cess pool

☐ Seepage pit  
☐ Pit privy  
☐ Sewage lagoon  
☐ Feedyard  
☐ Livestock pens

☒ Fuel storage  
☐ Fertilizer storage  
☐ Insecticide storage  
☐ Abandoned water well  
☐ Oil well/Gas well
☐ Other (specify below) \_\_\_\_\_

Direction from well? South(Sams Club Gas)  
 How many feet? 1,200

FROM	TO	PLUGGING MATERIALS	FROM	TO	PLUGGING MATERIALS
0	0.5	Asphalt			
0.5	19.64	Bentonite			

**7 CONTRACTOR'S OR LANDOWNER'S CERTIFICATION:** This water well was plugged under my jurisdiction and was completed on (mo/day/year) 11/15/18 and this record is true to the best of my knowledge and belief. Kansas Water Well Contractor's License No. 585. This Water Well Record was completed on (mo/day/year) 11/16/18 under the business name of Associated Environmental, Inc. by (signature) [Signature]

Send one white copy to Kansas Department of Health & Environment, Geology Section, 1000 SW Jackson Street, Ste. 420, Topeka, KS 66612-1367. Send one copy to WATER WELL OWNER and retain one for your records.

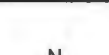

Visit us at <http://www.kdheks.gov/waterwell/index.html> Telephone 785-296-5524.

Shawnee

NW NW SE SE

32-11-15



DESIGNED BY: CC		<b>Potentiometric Surface Map</b>		Attachment	<b>First Quarter 2018</b>
DRAWN BY: CC		<b>First Quarter 2018</b>			
CHECKED BY: RW		 ppB EnviroSolutions professional   practical   below-ground	1149 SW Winding Road Topeka, Kansas		
APPROVED BY: CC					
DATE: MAY 2018					