

WATER WELL PLUGGING RECORD Form WWC-5P

KSA 82a-1212

ID NO.

MW3

1 LOCATION OF WATER WELL: Fraction NW 1/4 NW 1/4 SE 1/4 SE 1/4 Section Number 32 Township Number T 11 S Range Number 15 ☒ E ☐ W
County: Shawnee

Street/Rural Address of Well Location; if unknown, distance & direction from nearest town or intersection: If at owner's address, check here ☐ 1149 SW Winding Rd.
Topeka, KS 66615


Global Positioning Systems (GPS) information:

Latitude: 39.046178 (in decimal degrees)
Longitude: 95.766450 (in decimal degrees)
Elevation: 945.88
Horizontal Datum: ☒ WGS84, ☐ NAD83, ☐ NAD27
Collection Method:

2 WATER WELL OWNER: SB Ventures
RR#, St. Address, Box #: 3223 N. Hydraulic Ave.
City, State ZIP Code: Wichita, KS 67219-3803

☒ GPS unit (Make/Model: Garmen etrek)
☐ Digital Map/Photo. ☐ Topographic Map. ☐ Land Survey
Est. Accuracy: ☒ < 3 m, ☐ 3-5 m, ☐ 5-15 m, ☐ > 15 m

3 MARK WELL'S LOCATION WITH AN "X" IN SECTION BOX:

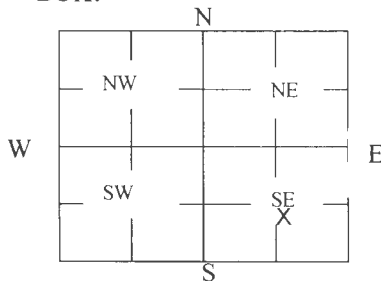

4 DEPTH OF WELL 29.09 ft.

WELL'S STATIC WATER LEVEL 22.29 ft

WELL WAS USED AS:

☐ Domestic ☐ Public Water Supply ☐ Dewatering
☐ Irrigation ☐ Oil Field Water Supply ☒ Monitoring
☐ Feedlot ☐ Domestic (Lawn & Garden) ☐ Injection Well
☐ Industrial ☐ Air Conditioning ☐ Other

Was a chemical/bacteriological sample submitted to Department? Yes ☐ No ☒

5 TYPE OF BLANK CASING USED:

☐ Steel ☐ RMP (SR) ☐ Wrought ☐ Fiberglass ☐ Other (Specify below)
☒ PVC ☐ ABS ☐ Asbestos-Cement ☐ Concrete Tile

Blank casing diameter 2 in. Was casing pulled? Yes ☒ No ☐ If yes, how much 3'
Casing height above or below land surface _____ in.

6 GROUT PLUG MATERIAL: ☐ Neat cement ☐ Cement grout ☒ Bentonite ☒ Other Topsoil

Grout Plug Intervals: From 29.09 ft. to 0.5 ft., From 0.5 ft. to 0 ft., From _____ ft. to _____ ft.

What is the nearest source of possible contamination:

☐ Septic tank ☐ Seepage pit ☒ Fuel storage ☐ Other (specify below)
☐ Sewer lines ☐ Pit privy ☐ Fertilizer storage
☐ Watertight sewer lines ☐ Sewage lagoon ☐ Insecticide storage
☐ Lateral lines ☐ Feedyard ☐ Abandoned water well Direction from well? South(Sams Club Gas)
☐ Cess pool ☐ Livestock pens ☐ Oil well/Gas well How many feet? 1,200

FROM	TO	PLUGGING MATERIALS	FROM	TO	PLUGGING MATERIALS
0	0.5	Topsoil			
0.5	29.09	Bentonite			

7 CONTRACTOR'S OR LANDOWNER'S CERTIFICATION: This water well was plugged under my jurisdiction and was completed on (mo/day/year) 11/15/18 and this record is true to the best of my knowledge and belief. Kansas Water Well Contractor's License No. 585. This Water Well Record was completed on (mo/day/year) 11/16/18 under the business name of Associated Environmental, Inc. by (signature) [Signature]

Send one white copy to Kansas Department of Health & Environment, Geology Section, 1000 SW Jackson Street, Ste. 420, Topeka, KS 66612-1367. Send one copy to WATER WELL OWNER and retain one for your records.
Visit us at <http://www.kdheks.gov/waterwell/index.html> Telephone 785-296-5524.

Shawnee

NW NW SE SE

32-11-15

March 2018 Potentiometric
Surface Contours



Monitoring Well

MW-1
930.57

MW-2
919.15

MW-3
920.23

12.30
10.30

RECEIVED

DEC 04 2018

BUREAU OF WATER

0 12.5 25 50 Feet

DESIGNED BY: CC
DRAWN BY: CC
CHECKED BY: RW
APPROVED BY: CC
DATE: MAY 2018



Potentiometric Surface Map
First Quarter 2018

ppB EnviroSolutions
professional | practical | below-ground

1149 SW Winding Road
Topeka, Kansas

Attachment

3

First Quarter 2018
Groundwater Sampling
Results Transmittal