USE TYPEWRITER OR BALL POINT PEN-PRESS FIRMLY, PRINT CLEARLY.

WATER WELL RECORD
KSA 82a-1201-1215

ADA

Kansas Department of Health and Environment-Division of Environment
(Water well Contractors)
Topeka, Kansas 66620

chg loc jd

1. Location of well:	County	Fraction	Section number	Township number	Range number
	Shawnee	~~SW~~ 1/4 SE 1/4 NE 1/4 (NE)	10	T 11 S	R 15 E W

2. Distance and direction from nearest town or city: 3 N
Street address of well location if in city: OF Topeka

3. Owner of well: Rod Graber
R.R. or street: 3617 N.W. Brickyard Rd.
City, state, zip code: Topeka Ks

4. Locate with "X" in section below:

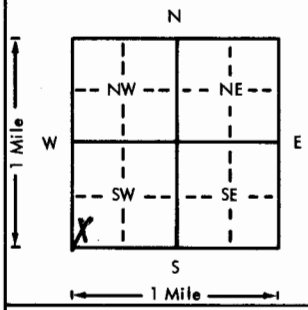

Sketch map:

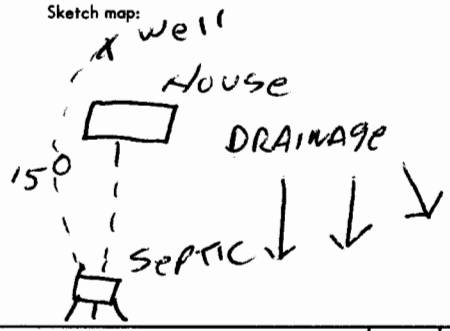

6. Bore hole dia. 10 in. Completion date 6-27-76
Well depth 80 ft.

7. __ Cable tool ✓ Rotary __ Driven __ Dug
__ Hollow rod __ Jetted __ Bored __ Reverse rotary

8. Use: ✓ Domestic __ Public supply __ Industry
__ Irrigation __ Air conditioning __ Stock
__ Lawn __ Oil field water __ Other

9. Casing: Material PVC Height: Above or below
Threaded ___ Welded ___ Surface 24 in.
RMP ___ PVC 9L Weight ~~2.58~~ lbs./ft. 2.74
Dia. 5 in. to 80 ft. depth Wall Thickness: inches or mm NC
Dia. ___ in. to ___ ft. depth gage No. ~~2.74~~ .258

10. Screen: Manufacturer's name PUMPCO
Type PVC Dia. 5
Slot/gauze .020 Length 20
Set between 56 ft. and 76 ft.
___ ft. and ___ ft.
Gravel pack? ✓ Size range of material .030 to .060

11. Static water level: mo./day/yr.
50 ft. below land surface Date 6-27-76

12. Pumping level below land surfaces: AIR TEST
___ ft. after ___ hrs. pumping ___ g.p.m.
___ ft. after ___ hrs. pumping ___ g.p.m.
Estimated maximum yield 20 g.p.m.

13. Water sample submitted: mo./day/yr.
__ Yes ✓ No Date

14. Well head completion: CAP
__ Pitless adapter 24 Inches above grade

15. Well grouted? ✓
With: ✓ Neat cement __ Bentonite __ Concrete
Depth: From 5 ft. to 15 ft.

16. Nearest source of possible contamination:
ft. 150 Direction S Type Septic
Well disinfected upon completion? ✓ Yes __ No

17. Pump: ✓ Not installed
Manufacturer's name
Model number HP Volts
Length of drop pipe ft. capacity g.p.m.
Type:
__ Submersible __ Turbine
__ Jet __ Reciprocating
__ Centrifugal __ Other

5. Type and color of material

	From	To
Top Soil	0	5
Brown Clay	5	53
Course Sand-gravel	53	66
Blue shale	66	80

(Use a second sheet if needed)

18. Elevation: ~945
Topography: Rm
✓ Hill
__ Slope
__ Upland
__ Valley

19. Remarks: OWNER WILL INSTAL SLAB

20. Water well contractor's certification:
This well was drilled under my jurisdiction and this report is true to the best of my knowledge and belief.
Business name: STRADER DRLG CO INC 182 License No.
Address: RT 1 Horton Ks
Signed: Dale Ackron Date 7-7-76
Authorized representative

T 11 R 15 W Sec 10 1/4 1/4 1/4 NE

Forward the white, blue and pink copies to the Department of Health and Environment

Form WWC-5