WATER WELL RECORD Form WWC-5 KSA 82a-1212

LOCATION OF WATER WELL: County: Shawnee | Fraction: ~~SW~~ SE¼ SW¼ SW¼ | Section Number: 6 | Township Number: T 11 S | Range Number: R 15 E W

Distance and direction from nearest town or city? 1.5N .4E OF Kiro | Street address of well if located within city?

WATER WELL OWNER: Norman Hinderliter
RR#, St. Address, Box #: N.W. 39
City, State, ZIP Code: Silver Lake, Ks 66539
Board of Agriculture, Division of Water Resources Application Number:

DEPTH OF COMPLETED WELL 100 ft. Bore Hole Diameter 12 in. to ft., and in. to ft.

Well Water to be used as: 1 Domestic 2 Irrigation 3 Feedlot 4 Industrial 5 Public water supply 6 Oil field water supply 7 Lawn and garden only 8 Air conditioning 9 Dewatering 10 Observation well 11 Injection well 12 Other (Specify below)

Well's static water level 65 ft. below land surface measured on November month 12 day 1980 year

Pump Test Data: Well water was ft. after hours pumping gpm
Est. Yield 30 gpm: Well water was ft. after hours pumping gpm

TYPE OF BLANK CASING USED: 1 Steel 2 PVC 3 RMP (SR) 4 ABS 5 Wrought iron 6 Asbestos-Cement 7 Fiberglass 8 Concrete tile 9 Other (specify below)

Casing Joints: Glued ✓ Clamped Welded Threaded

Blank casing dia 5 in. to 0-80 ft., Dia 5 in. to 90-100 ft., Dia in. to ft.

Casing height above land surface 24 in., weight 2.36 lbs./ft. Wall thickness or gauge No. 214

TYPE OF SCREEN OR PERFORATION MATERIAL: 1 Steel 2 Brass 3 Stainless steel 4 Galvanized steel 5 Fiberglass 6 Concrete tile 7 PVC 8 RMP (SR) 9 ABS 10 Asbestos-cement 11 Other (specify) 12 None used (open hole)

Screen or Perforation Openings Are: 1 Continuous slot 2 Louvered shutter 3 Mill slot 4 Key punched 5 Gauzed wrapped 6 Wire wrapped 7 Torch cut 8 Saw cut 9 Drilled holes 10 Other (specify) 11 None (open hole)

Screen-Perforation Dia 5 in. to ft., Dia in. to ft., Dia in. to ft.

Screen-Perforated Intervals: From 80 ft. to 90 ft., From ft. to ft.
From ft. to ft., From ft. to ft.

Gravel Pack Intervals: From 15 ft. to 100 ft., From ft. to ft.
From ft. to ft., From ft. to ft.

GROUT MATERIAL: 1 Neat cement 2 Cement grout 3 Bentonite 4 Other

Grouted Intervals: From 5 ft. to 15 ft., From ft. to ft., From ft. to ft.

What is the nearest source of possible contamination: 1 Septic tank 2 Sewer lines 3 Lateral lines 4 Cess pool 5 Seepage pit 6 Pit privy 7 Sewage lagoon 8 Feed yard 9 Livestock pens 10 Fuel storage 11 Fertilizer storage 12 Insecticide storage 13 Watertight sewer lines 14 Abandoned water well 15 Oil well/Gas well 16 Other (specify below)

Direction from well W How many feet 115? Water Well Disinfected? Yes ✓ No

Was a chemical/bacteriological sample submitted to Department? Yes No ✓ If yes, date sample was submitted month day year: Pump Installed? Yes ✓ No

If Yes: Pump Manufacturer's name Goulds Model No. 5ES HP 1/2 Volts 230
Depth of Pump Intake 60 ft. Pumps Capacity rated at 10 gal./min.
Type of pump: (1 Submersible) 2 Turbine 3 Jet 4 Centrifugal 5 Reciprocating 6 Other

CONTRACTOR'S OR LANDOWNER'S CERTIFICATION: This water well was (1) constructed, (2) reconstructed, or (3) plugged under my jurisdiction and was completed on November month 12 day 1980 year. And this record is true to the best of my knowledge and belief. Kansas Water Well Contractor's License No. 182. This Water Well Record was completed on November month 26 day 1980 year under the business name of STRADER DRLG CO INC by (signature) Dale Askren

LOCATE WELL'S LOCATION WITH AN "X" IN SECTION BOX: 2/10

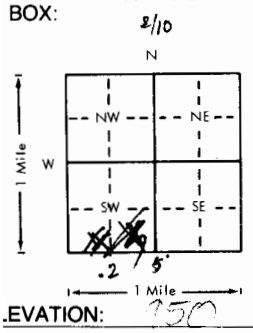

ELEVATION: 1250

FROM	TO	LITHOLOGIC LOG	FROM	TO	LITHOLOGIC LOG
0	4	Top Soil			
4	60	Clay, brown			
60	70	SILTY clay			
70	80	Clay, brown			
80	86	Fine Sand Course Sand			
86	100	Shaley, limestone			

Depth(s) Groundwater Encountered 1. 65 ft. 2. ft. 3. ft. 4. ft. (Use a second sheet if needed)

INSTRUCTIONS: Use typewriter or ball point pen, *please press firmly* and *PRINT* clearly. Please fill in blanks, underline or circle the correct answers. Send top three copies to Kansas Department of Health and Environment, Division of Environment, Water Well Contractors, Topeka, KS 66620. Send one to WATER WELL OWNER and retain one for your records.

OFFICE USE ONLY T 11 R 15 E W SEC. 6 SE¼ SE¼ SW¼