

292-112

GROVE

use
ED or CF

USE TYPEWRITER OR BALL POINT PEN-PRESS FIRMLY, PRINT CLEARLY.


WATER WELL RECORD
KSA 82a-1201-1215

Kansas Department of Health and Environment-Division of Environment (Water well Contractors) Topeka, Kansas 66620

ok 6/18/81

Location of well: X	County: Shawnee	Fraction: NW 1/4 NW 1/4 NW 1/4	Section number: 6	Township number: T 5 S	Range number: R 15 E
----------------------------	------------------------	---------------------------------------	--------------------------	-------------------------------	-----------------------------

Distance and direction from nearest town or city: 2.5 N of Kiro	Street address of well location if in city: of Kiro	3. Owner of well: Mark Hanson	R.R. or street: 7520 NW 46th St	City, state, zip code: Topeka, KS 66618
--	--	--------------------------------------	--	--

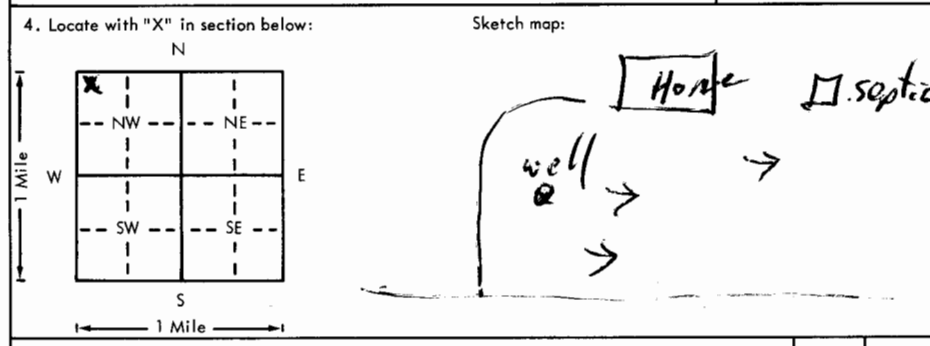

6. Bore hole dia: 5 1/2 in.	Completion date: 4/24/81
Well depth: 54 ft.	
7. <input checked="" type="checkbox"/> Cable tool	<input type="checkbox"/> Rotary <input type="checkbox"/> Driven <input type="checkbox"/> Dug
<input type="checkbox"/> Hollow rod	<input type="checkbox"/> Jetted <input type="checkbox"/> Bored <input type="checkbox"/> Reverse rotary
8. Use: <input checked="" type="checkbox"/> Domestic	<input type="checkbox"/> Public supply <input type="checkbox"/> Industry
<input type="checkbox"/> Irrigation	<input type="checkbox"/> Air conditioning <input type="checkbox"/> Stock
<input type="checkbox"/> Lawn	<input type="checkbox"/> Oil field water <input type="checkbox"/> Other
9. Casing: Material PITS	Height: Above or below
Threaded <input type="checkbox"/> Welded <input type="checkbox"/> Surface 24 in.	
RMP <input checked="" type="checkbox"/> PVC <input type="checkbox"/> Weight _____ lbs./ft.	
Dia. 5 in. to 54 ft. depth	Wall Thickness: inches or
Dia. _____ in. to _____ ft. depth	gage No. 200

5. Type and color of material	From	To
Top Soil	0	3
Clay	3	25
Clay some sand	25	37
Sand med coarse dirty	37	43
Sand med coarse fair	43	54
(Use a second sheet if needed)		

10. Screen: Manufacturer's name Sunflower
Type AMP Dia. 5 1/2
Slot/gauze 050 Length 5'
Set between 46 ft. and 54 ft.
Gravel pack? NO Size range of material _____
11. Static water level: _____ mo./day/yr.
17 ft. below land surface Date 4/31/81
12. Pumping level below land surfaces:
_____ ft. after _____ hrs. pumping _____ g.p.m.
_____ ft. after _____ hrs. pumping _____ g.p.m.
Estimated maximum yield 20+ g.p.m.
13. Water sample submitted: _____ mo./day/yr.
<input type="checkbox"/> Yes <input checked="" type="checkbox"/> No Date _____
14. Well head completion:
<input checked="" type="checkbox"/> Pitless adapter _____ inches above grade
15. Well grouted? yes
With: <input checked="" type="checkbox"/> Neat cement <input type="checkbox"/> Bentonite <input type="checkbox"/> Concrete
Depth: From 0 ft. to 16 ft.
16. Nearest source of possible contamination:
ft. 100+ Direction west Type Septic
Well disinfected upon completion? <input checked="" type="checkbox"/> Yes <input type="checkbox"/> No
17. Pump: _____ Not installed
Manufacturer's name Jacuzzi
Model number 54A HP 1/3 Volts 230
Length of drop pipe 54 ft. capacity 8 g.p.m.
Type:
<input checked="" type="checkbox"/> Submersible <input type="checkbox"/> Turbine
<input type="checkbox"/> Jet <input type="checkbox"/> Reciprocating
<input type="checkbox"/> Centrifugal <input type="checkbox"/> Other

18. Elevation: **915**

Topography:

Hill

Slope

Upland

Valley

19. Remarks:

owner to install cement slab

20. Water well contractor's certification:

This well was drilled under my jurisdiction and this report is true to the best of my knowledge and belief.

Business name **Robison Drilling 316**

Address **Jack Perry KS**

Signed **Jack Perry** Date **6/14/81**

Authorized representative

11 150 6 NW 1/4