

USE TYPEWRITER OR BALL POINT PEN-PRESS FIRMLY, PRINT CLEARLY.

WATER WELL RECORD  
KSA 82a-1201-1215


sec 1/4 1/4 1/4 No.

Kansas State Dept. Of Health  
(Water Well Contractors)  
Forbes-Bldg. 740  
Topeka, Kansas 66620

SW NW SW

1 Location of well:	County <b>Shawnee</b>	Township name	Fraction <b>SW 1/4</b>	Section number <b>6</b>	Town number <b>11 S</b>	Range number <b>R 15 E</b>
---------------------	--------------------------	---------------	---------------------------	----------------------------	----------------------------	-------------------------------

Distance and direction from nearest town or city:	3 Owner of well: <b>Joe Estes</b>
Street address of well location if in city:	Address: <b>1 1/2 North Kirb</b>

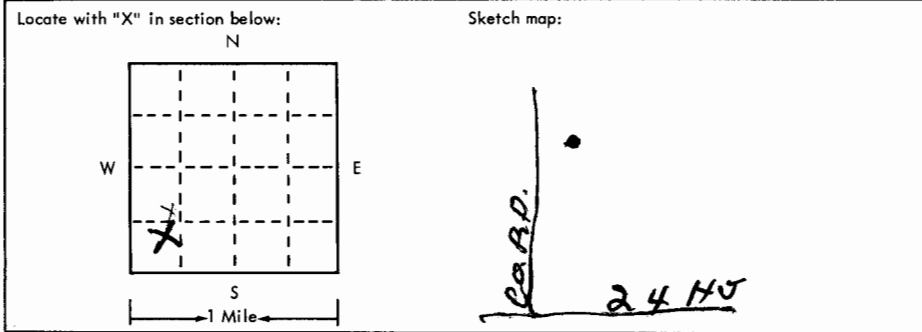

4 Well depth: **90** ft. Date of completion: **5/6/75**  
Well diameter: **6-5/8** in.

5  Cable tool  Rotary  Driven  Dug  
 Hollow rod  Jetted  Bored  Reverse rotary

6 Use:  Domestic  Public supply  Industry  
 Irrigation  Air conditioning  Commercial  
 Test well

7 Casing: Material **steel** Height: above/below  
Threaded  Welded  Surface **24** in.  
Diam. Weight **19** lbs./ft.  
**6-5/8** in. to **60** ft. depth Drive shoe?  Yes  No  
**5** in. to **90** ft. depth!

2	Type and color of material	From	To
	Sandy clay	0	31
	Fine streaks of sand	31	55
	Fine brown sand	55	58
	Shale	58	60
	Brown sandstone	60	88
	Shale	88	90
	Owner to rone 4' x 4' x 4" slab		
	(use a second sheet if needed)		

8 Screen: Manufacturer **Field**  
Type **P.V.C.** Dia. **40**  
Slot/gauze Length **40**  
Set between **50** ft. and **90** ft.  
Fittings: Gravel pack  Yes  No Size range of material

9 Static water level: **52** ft. below land surface Date **5/6/75**

10 Pumping level below land surfaces:  
\_\_\_\_ ft. after \_\_\_\_ hrs. pumping \_\_\_\_ g.p.m.  
\_\_\_\_ ft. after \_\_\_\_ hrs. pumping \_\_\_\_ g.p.m.  
Estimated maximum yield **5** g.p.m.

11 Water sample submitted:  
 Yes  No Date

12 Well head completion:  
 Pitless adapter  Inches above grade

13 Well grouted?  Yes  No  
 Neat cement  Bentonite  
Depth: From **0** ft. to **20** ft.

14 Nearest source of possible contamination:  
ft. \_\_\_\_ Direction \_\_\_\_ Type \_\_\_\_  
Well disinfected upon completion?  Yes  No

15 Pump:  Not installed  
Manufacturer's name  
Model number \_\_\_\_ HP \_\_\_\_ Volts \_\_\_\_  
Length of drop pipe \_\_\_\_ ft. capacity \_\_\_\_ g.m.p.  
Type:  
 Submersible  Turbine  
 Jet  Reciprocating  
 Centrifugal  Other

16 Remarks: elevation **995"**

Topography:  
 Hill  
 Slope  
 Upland  
 Valley

17 Water well contractor's certification:  
This well was drilled under my jurisdiction and this report is true to the best of my knowledge and belief.

**Jungmann Bros. Drilling Co.**  
Business name **Carbondale, Ks.** License No. **119**  
Address  
Signed **[Signature]** Date **5-6-75**  
Authorized representative

BR = 887      ∇ = 893