


WATER WELL RECORD Form WWC-5 KSA 82a-1212

1 LOCATION OF WATER WELL:	Fraction	Section Number	Township Number	Range Number
County: SHAWNEE	SE ¼ SE ¼ SW ¼	6	T 11 S	R XX 15 E

Distance and direction from nearest town or city street address of well if located within city?
 1/2 mile east of Topeka

2 WATER WELL OWNER: **Tim Desch**
 RR#, St. Address, Box # : **1942 N. Madison**
 City, State, ZIP Code : **Topeka, KS 66608**

Board of Agriculture, Division of Water Resources
 Application Number: **39,542**

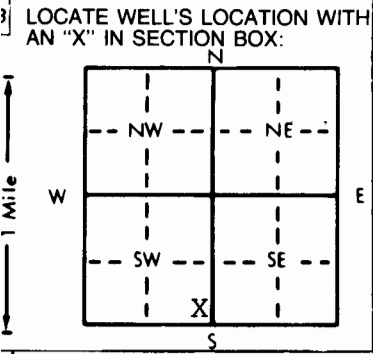

4 DEPTH OF COMPLETED WELL: **40'** ft. ELEVATION: _____ ft.

Depth(s) Groundwater Encountered 1. _____ ft. 2. _____ ft. 3. _____ ft.

WELL'S STATIC WATER LEVEL **17'-6"** ft. below land surface measured on mo/day/yr **6-12-90**

Pump test data: Well water was _____ ft. after _____ hours pumping _____ gpm
 Est. Yield **400** gpm: Well water was _____ ft. after _____ hours pumping _____ gpm

Bore Hole Diameter _____ in. to _____ ft., and _____ in. to _____ ft.

WELL WATER TO BE USED AS:

5 Public water supply	8 Air conditioning	11 Injection well
1 Domestic	3 Feedlot	6 Oil field water supply
2 Irrigation	4 Industrial	7 Lawn and garden only
		9 Dewatering
		10 Monitoring well
		12 Other (Specify below)

Was a chemical/bacteriological sample submitted to Department? Yes _____ No **X** _____; If yes, mo/day/yr sample was submitted _____
 Water Well Disinfected? Yes **X** No

5 TYPE OF BLANK CASING USED:

1 Steel	3 RMP (SR)	5 Wrought iron	8 Concrete tile	CASING JOINTS: Glued _____ Clamped _____
2 PVC	4 ABS	6 Asbestos-Cement	9 Other (specify below)	Welded X _____
		7 Fiberglass		Threaded _____

Blank casing diameter **16"** in. to **0-25** ft., Dia **16"** in. to **35-40** ft., Dia _____ in. to _____ ft.
 Casing height above land surface **1'-8"** in., weight **42** lbs./ft. Wall thickness or gauge No. **250**

TYPE OF SCREEN OR PERFORATION MATERIAL:

1 Steel	3 Stainless steel Johnson	5 Fiberglass	7 PVC	10 Asbestos-cement
2 Brass	4 Galvanized steel .080	6 Concrete tile	8 RMP (SR)	11 Other (specify) _____
			9 ABS	12 None used (open hole)

SCREEN OR PERFORATION OPENINGS ARE: **slott**

1 Continuous slot	3 Mill slot	5 Gauzed wrapped	8 Saw cut	11 None (open hole)
2 Louvered shutter	4 Key punched	6 Wire wrapped	9 Drilled holes	
		7 Torch cut	10 Other (specify) _____	

SCREEN-PERFORATED INTERVALS: From **25** ft. to **35** ft., From _____ ft. to _____ ft.
 From _____ ft. to _____ ft., From _____ ft. to _____ ft.

GRAVEL PACK INTERVALS: From **22** ft. to **40** ft., From _____ ft. to _____ ft.
 From _____ ft. to _____ ft., From _____ ft. to _____ ft.

6 GROUT MATERIAL: **1 Neat cement** 2 Cement grout 3 Bentonite 4 Other _____

Grout Intervals: From **0** ft. to **22** ft., From _____ ft. to _____ ft., From _____ ft. to _____ ft.

What is the nearest source of possible contamination:

1 Septic tank	4 Lateral lines	7 Pit privy	10 Livestock pens	14 Abandoned water well
2 Sewer lines	5 Cess pool	8 Sewage lagoon	11 Fuel storage	15 Oil well/Gas well
3 Watertight sewer lines	6 Seepage pit	9 Feedyard	12 Fertilizer storage	16 Other (specify below)
			13 Insecticide storage	

Direction from well? **East** How many feet? **315'**

FROM	TO	LITHOLOGIC LOG	FROM	TO	PLUGGING INTERVALS
0	2	Top Soil			
2	17	Fine Sand-Brown			
17	30	Fine Sand-Coarse Sand-Med-Pea Gravel, Brown			
30	35	Fine Sand-Coarse Sand-Med-Pea Gravel-Green, Blue			
35	40	Shale-Grey			

7 CONTRACTOR'S OR LANDOWNER'S CERTIFICATION: This water well was (1) constructed, (2) reconstructed, or (3) plugged under my jurisdiction and was completed on (mo/day/year) **6-01-90** and this record is true to the best of my knowledge and belief. Kansas Water Well Contractor's License No. **182** This Water Well Record was completed on (mo/day/yr) **7-27-99** under the business name of **STRADER DRILLING CO., INC.** by (signature) *Dale Skren*

INSTRUCTIONS: Use typewriter or ball point pen. PLEASE PRESS FIRMLY and PRINT clearly. Please fill in blanks, underline or circle the correct answers. Send top three copies to Kansas Department of Health and Environment, Bureau of Water, Topeka, Kansas 66620-7320. Telephone: 913-296-5545. Send one to WATER WELL OWNER and retain one for your records.