294 * 112

Yd

USE TYPEWRITER OR BALL POINT PEN-PRESS FIRMLY, PRINT CLEARLY.

WATER WELL RECORD
KSA 82a-1201-1215

CCC

Kansas Department of Health and Environment-Division of Environment
(Water well Contractors)
Topeka, Kansas 66620

1. Location of well:	County	Fraction	Section number	Township number	Range number
	SHAWNEE	SW 1/4 SW 1/4 SW 1/4	7	T 11 S	R 15 E/W

2. Distance and direction from nearest town or city: 3 M EAST OF SILVER LAKE
Street address of well location if in city: JUST OFF Hyw. 24

3. Owner of well: G. FLEMING.
R.R. or street: 7530 KIRO CT.
City, state, zip code: SILVER LAKE KAN

4. Locate with "X" in section below:

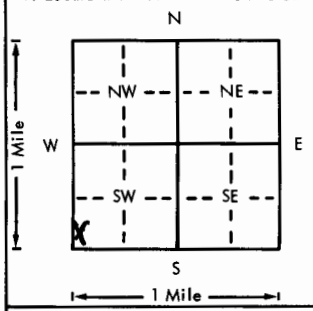

Sketch map:

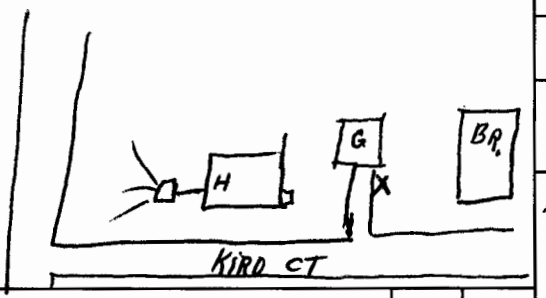

6. Bore hole dia. 8 in. Completion date 10-10-76
Well depth 47 ft.

7. __ Cable tool __ Rotary __ Driven __ Dug
__ Hollow rod __ Jetted X Bored __ Reverse rotary

8. Use: X Domestic __ Public supply __ Industry
__ Irrigation __ Air conditioning __ Stock
__ Lawn __ Oil field water __ Other

9. X Casing: Material _____ Height: Above or below
Threaded ____ Welded ____ surface 16 in.
RMP X PVC ____ Weight ____ lbs./ft.
Dia. 5 in. to 47 ft. depth Wall Thickness: inches or
Dia. ____ in. to ____ ft. depth gage No. 200

10. X Screen: Manufacturer's name SUN FLOWER
Type STAINLESS Dia. 5
Slot/gauze V 11 Length 5"
Set between 42 ft. and 47 ft.
____ ft. and ____ ft.
Gravel pack? V Size range of material 1/4"

11. Static water level: mo./day/yr.
31 ft. below land surface Date 10-10-76

12. Pumping level below land surfaces:
31 ft. after 2 hrs. pumping 16 g.p.m.
____ ft. after ____ hrs. pumping ____ g.p.m.
Estimated maximum yield 24 g.p.m.

13. Water sample submitted: mo./day/yr.
____ Yes V No Date ____

14. Well head completion:
V Pitless adapter 12 Inches above grade

15. Well grouted? V
With: V Neat cement ____ Bentonite ____ Concrete
Depth: From 3 ft. to 13 ft.

16. Nearest source of possible contamination:
ft. 80' Direction SW Type S. TANK
Well disinfected upon completion? V Yes ____ No

17. Pump: V Not installed
Manufacturer's name GOULDS
Model number 7E4 HP 1/2 Volts 115
Length of drop pipe 40 ft. capacity 10 g.p.m.
Type:
V Submersible ____ Turbine
____ Jet ____ Reciprocating
____ Centrifugal ____ Other

5. Type and color of material

Type and color of material	From	To
Top SOIL	0	6
HARD PAN GRAY Gumbo	6	15
BROWN SILT	15	21
HARD PAN GRAY	21	23
SANDY SILT	23	30
SAND + GRAVEL	31	43
GAVEL WITH SOME FINE SAND	43	47

(Use a second sheet if needed)

18. Elevation: 900
Topography:
____ Hill
____ Slope
____ Upland
____ Valley

19. Remarks: Slot installed by Owner

20. Water well contractor's certification:
This well was drilled under my jurisdiction and this report is true to the best of my knowledge and belief.
Business name H.L. PETTIT 333 License No.
Address 905 N MICHIGAN
Signed H.L. Pettit Authorized representative Date 10-22-76

T 11 S R 15 E/W Sec 7 1/4 1/4 1/4 1/4

Forward the white, blue and pink copies to the Department of Health and Environment

Form WWC-5