


LOCATION OF WATER WELL: County: SHAWNEE Fraction: NW 1/4 NW 1/4 NW 1/4 Section Number: 8 Township Number: T 11 S Range Number: R 15 E E/W

Distance and direction from nearest town or city street address of well if located within city?
2 MI W 1/2 WEST 3/4 N TOPEKA.
 WATER WELL OWNER: DANIEL J. FUNK 3904 FLEMONT TOPEKA.
 RR#, St. Address, Box #: 5140 NW JENNINGS RD KTS Board of Agriculture, Division of Water Resources
 City, State, ZIP Code: _____ Application Number: _____

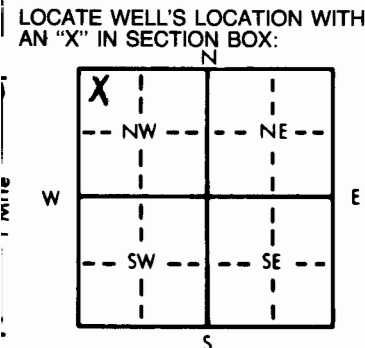

4 DEPTH OF COMPLETED WELL: 165 ft. ELEVATION: _____
 Depth(s) Groundwater Encountered 1. 94 ft. 2. 165 ft. 3. _____ ft.
 WELL'S STATIC WATER LEVEL: 45 ft. below land surface measured on mo/day/yr JULY 27 - 85
 Pump test data: Well water was _____ ft. after _____ hours pumping _____ gpm
 Est. Yield 1 gpm: Well water was BAILED hours pumping _____ gpm
 Bore Hole Diameter: 9 in. to 24 in. and 6 1/4 in. to 165 ft.
 WELL WATER TO BE USED AS:
 1 Domestic 3 Feedlot 6 Oil field water supply 9 Dewatering 12 Other (Specify below)
 2 Irrigation 4 Industrial 7 Lawn and garden only 10 Observation well
 Was a chemical/bacteriological sample submitted to Department? Yes No If yes, mo/day/yr sample was submitted _____
 Water Well Disinfected? Yes No _____

TYPE OF BLANK CASING USED:
 1 Steel 3 RMP (SR)
 2 PVC 4 ABS
 5 Wrought iron 8 Concrete tile CASING JOINTS: Glued _____ Clamped _____
 6 Asbestos-Cement 9 Other (specify below) _____ Welded _____
 7 Fiberglass _____ Threaded _____
 Blank casing diameter: 5 in. to 50 ft., Dia _____ in. to _____ ft., Dia _____ in. to _____ ft.
 Casing height above land surface: 12 in., weight _____ lbs./ft. Wall thickness or gauge No. S.D.A. 26

TYPE OF SCREEN OR PERFORATION MATERIAL:
 1 Steel 3 Stainless steel 5 Fiberglass 7 PVC 10 Asbestos-cement
 2 Brass 4 Galvanized steel 6 Concrete tile 8 RMP (SR) 11 Other (specify) _____
 12 None used (open hole)
 SCREEN OR PERFORATION OPENINGS ARE:
 1 Continuous slot 3 Mill slot 5 Gauzed wrapped 8 Saw cut 11 None (open hole)
 2 Louvered shutter 4 Key punched 6 Wire wrapped 9 Drilled holes
 7 Torch cut 10 Other (specify) _____

SCREEN-PERFORATED INTERVALS: From 50 ft. to 165 ft., From _____ ft. to _____ ft.
 From _____ ft. to _____ ft., From _____ ft. to _____ ft.
 GRAVEL PACK INTERVALS: From 24 ft. to 50 ft., From _____ ft. to _____ ft.
 From _____ ft. to _____ ft., From _____ ft. to _____ ft.

GROUT MATERIAL: 1 Neat cement 2 Cement grout 3 Bentonite 4 Other _____
 Grout intervals: From 0 ft. to 24 ft., From _____ ft. to _____ ft., From _____ ft. to _____ ft.
 What is the nearest source of possible contamination:
 1 Septic tank 4 Lateral lines 7 Pit privy 10 Livestock pens 14 Abandoned water well
 2 Sewer lines 5 Cess pool 8 Sewage lagoon 11 Fuel storage 15 Oil well/Gas well
 3 Watertight sewer lines 6 Seepage pit 9 Feedyard 12 Fertilizer storage 16 Other (specify below) UNKNOWN
 13 Insecticide storage

Direction from well? _____ How many feet? _____

FROM	TO	LITHOLOGIC LOG	FROM	TO	LITHOLOGIC LOG
0	24	CLAY YELLOW			
24	27	SHELLEY LIME 24" APP 12"			
27	29	LIME			
29	51	SHALE			
51	57	LIME			
57	80	SHALE			
80	90	SANDY SHALE			
90	92	LIME			
92	94	SHALE			
94	110	BROWN SANDY SHALE			
110	120	SANDY SHALE			
120	165	SAND HARD			

CONTRACTOR'S OR LANDOWNER'S CERTIFICATION: This water well was (1) constructed, (2) reconstructed, or (3) plugged under my jurisdiction and was completed on (mo/day/year) JULY 27 - 85 and this record is true to the best of my knowledge and belief. Kansas Water Well Contractor's License No. 119A This Water Well Record was completed on (mo/day/yr) JULY 28 - 85 under the business name of JENNINGS BROS DRILLING CO by (signature) _____

INSTRUCTIONS: Use typewriter or ball point pen, PLEASE PRESS FIRMLY and PRINT clearly. Please fill in blanks, underline or circle the correct answers. Send top three copies to Kansas Department of Health and Environment, Division of Environment, Environmental Geology Section, Topeka, KS 66620. Send one to WATER WELL OWNER and retain one for your records.