

LOCATION OF WATER WELL: County: SHAWNEE	Fraction SE 1/4 NW 1/4 NW 1/4	Section Number 9	Township Number T 11 S	Range Number R 15 E/W
---	---	----------------------------	----------------------------------	---------------------------------


Distance and direction from nearest town or city street address of well if located within city?

1 1/2 north, 2 west of Topeka

WATER WELL OWNER: **Ron Schmidt**
 R#, St. Address, Box #: **121 NW 58th**
 City, State, ZIP Code: **Topeka, KS 66617**

Board of Agriculture, Division of Water Resources
 Application Number:

LOCATE WELL'S LOCATION WITH AN "X" IN SECTION BOX:

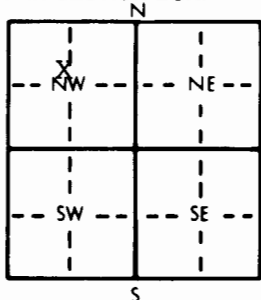

4 DEPTH OF COMPLETED WELL: **95** ft. ELEVATION: _____ ft.
 Depth(s) Groundwater Encountered 1. **74'** ft. 2. _____ ft. 3. _____ ft.
 WELL'S STATIC WATER LEVEL: **60'** ft. below land surface measured on mo/day/yr **7-31-90**
 Pump test data: Well water was _____ ft. after _____ hours pumping _____ gpm
 Est. Yield **8** gpm: Well water was _____ ft. after _____ hours pumping _____ gpm
 Bore Hole Diameter: **12"** in. to _____ ft., and _____ in. to _____ ft.
 WELL WATER TO BE USED AS:
 5 Public water supply 8 Air conditioning 11 Injection well
 1 Domestic 3 Feedlot 6 Oil field water supply 9 Dewatering 12 Other (Specify below)
 2 Irrigation 4 Industrial 7 Lawn and garden only 10 Monitoring well _____
 Was a chemical/bacteriological sample submitted to Department? Yes _____ No **X**; If yes, mo/day/yr sample was submitted _____
 Water Well Disinfected? Yes **X** No _____

TYPE OF BLANK CASING USED:
 1 Steel 3 RMP (SR) 5 Wrought iron 8 Concrete tile CASING JOINTS: Glued **X** Clamped _____
 2 PVC 4 ABS 6 Asbestos-Cement 9 Other (specify below) Welded _____
 7 Fiberglass _____ Threaded _____

Blank casing diameter: **5"** in. to **0-65** ft., Dia **5"** in. to **80-95** ft., Dia _____ in. to _____ ft.
 Casing height above land surface: **24"** in., weight **2.82** lbs./ft. Wall thickness or gauge No. **.258**

TYPE OF SCREEN OR PERFORATION MATERIAL:
 1 Steel 3 Stainless steel 5 Fiberglass 7 PVC 10 Asbestos-cement
 2 Brass 4 Galvanized steel 6 Concrete tile 8 RMP (SR) 11 Other (specify) _____
 9 ABS 12 None used (open hole)

SCREEN OR PERFORATION OPENINGS ARE:
 1 Continuous slot 3 Mill slot 5 Gauzed wrapped 8 Saw cut 11 None (open hole)
 2 Louvered shutter 4 Key punched 6 Wire wrapped 9 Drilled holes
 7 Torch cut 10 Other (specify) _____

SCREEN-PERFORATED INTERVALS: From **65** ft. to **80** ft., From _____ ft. to _____ ft.
 From _____ ft. to _____ ft., From _____ ft. to _____ ft.
 GRAVEL PACK INTERVALS: From **24** ft. to **95** ft., From _____ ft. to _____ ft.
 From _____ ft. to _____ ft., From _____ ft. to _____ ft.

GROUT MATERIAL: 1 Neat cement 2 Cement grout 3 Bentonite 4 Other **hole plug**
 Grout Intervals: From **4** ft. to **24** ft., From _____ ft. to _____ ft., From _____ ft. to _____ ft.

What is the nearest source of possible contamination:
 1 Septic tank 4 Lateral lines 7 Pit privy 10 Livestock pens 14 Abandoned water well
 2 Sewer lines 5 Cess pool 8 Sewage lagoon 11 Fuel storage 15 Oil well/Gas well
 3 Watertight sewer lines 6 Seepage pit 9 Feedyard 12 Fertilizer storage 16 Other (specify below)
 13 Insecticide storage _____
 Direction from well? **south** How many feet? **130'**

FROM	TO	LITHOLOGIC LOG	FROM	TO	PLUGGING INTERVALS
0	2	Top Soil			
2	42	Clay-Brown			
42	43	Boulders			
43	49	Fine Sand-Brown			
49	55	Fine Sand-Coarse Sand-Brown			
55	56	Boulders			
56	75	Fine Sand-Coarse Sand-Med-Gravel-Brown			
75	95	Shale-Grey			

CONTRACTOR'S OR LANDOWNER'S CERTIFICATION: This water well was (1) constructed, (2) reconstructed, or (3) plugged under my jurisdiction and was completed on (mo/day/year) **7-31-90** and this record is true to the best of my knowledge and belief. Kansas Water Well Contractor's License No. **182** This Water Well Record was completed on (mo/day/yr) **9-11-90** under the business name of **STRADER DRILLING CO., INC.** by (signature) *[Signature]*

OFFICE USE ONLY
T
R
EW
SEC
1/4
1/4