


1 LOCATION OF WATER WELL: Fraction NW 1/4 SE 1/4 NW 1/4 Section Number 9 Township Number T 11 S Range Number R 15 E/W  
 County: SHAWNEE

Distance and direction from nearest town or city street address of well if located within city?  
 1 north, 1 1/2 west of Topeka

2 WATER WELL OWNER: Robert Kelley  
 RR#, St. Address, Box #: 3551 NW Menoken Board of Agriculture, Division of Water Resources  
 City, State, ZIP Code: Topeka, Kansas Application Number:

3 LOCATE WELL'S LOCATION WITH AN "X" IN SECTION BOX:

4 DEPTH OF COMPLETED WELL... 95' ft. ELEVATION:

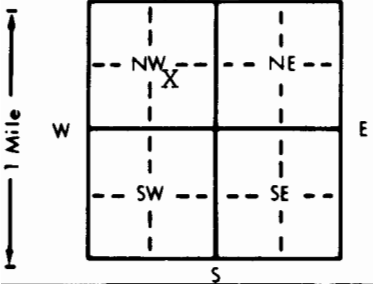

Depth(s) Groundwater Encountered 1... 77' ft. 2... ft. 3... ft.  
 WELL'S STATIC WATER LEVEL... 63' ft. below land surface measured on mo/day/yr... 5-26-93  
 Pump test data: Well water was... ft. after... hours pumping... gpm  
 Est. Yield... 8... gpm: Well water was... ft. after... hours pumping... gpm  
 Bore Hole Diameter... 12" in. to... ft., and... in. to... ft.  
 WELL WATER TO BE USED AS: 5 Public water supply 8 Air conditioning 11 Injection well  
 1 Domestic 3 Feedlot 6 Oil field water supply 9 Dewatering 12 Other (Specify below)  
 2 Irrigation 4 Industrial 7 Lawn and garden only 10 Monitoring well  
 Was a chemical/bacteriological sample submitted to Department? Yes... No... X...; If yes, mo/day/yr sample was submitted  
 Water Well Disinfected? Yes X No

5 TYPE OF BLANK CASING USED: 5 Wrought iron 8 Concrete tile CASING JOINTS: Glued... Clamped...  
 1 Steel 3 RMP (SR) 6 Asbestos-Cement 9 Other (specify below) Welded...  
 2 PVC 4 ABS 7 Fiberglass Threaded...

Blank casing diameter... 5" in. to... 0-60... ft., Dia... 5" in. to... 80-95... ft., Dia... in. to... ft.  
 Casing height above land surface... 24" in., weight... 2.82... lbs./ft. Wall thickness or gauge No... 258

TYPE OF SCREEN OR PERFORATION MATERIAL: 7 PVC 10 Asbestos-cement  
 1 Steel 3 Stainless steel 5 Fiberglass 8 RMP (SR) 11 Other (specify)...  
 2 Brass 4 Galvanized steel 6 Concrete tile 9 ABS 12 None used (open hole)

SCREEN OR PERFORATION OPENINGS ARE: 5 Gauzed wrapped 8 Saw cut 11 None (open hole)  
 1 Continuous slot 3 Mill slot 6 Wire wrapped 9 Drilled holes  
 2 Louvered shutter 4 Key punched 7 Torch cut 10 Other (specify)...

SCREEN-PERFORATED INTERVALS: From... 60... ft. to... 80... ft., From... ft. to... ft.  
 GRAVEL PACK INTERVALS: From... 24... ft. to... 95... ft., From... ft. to... ft.

6 GROUT MATERIAL: 1 Neat cement 2 Cement grout 3 Bentonite 4 Other  
 Grout Intervals: From... 4... ft. to... 24... ft., From... ft. to... ft., From... ft. to... ft.

What is the nearest source of possible contamination:  
 1 Septic tank 4 Lateral lines 7 Pit privy 10 Livestock pens 14 Abandoned water well  
 2 Sewer lines 5 Cess pool 8 Sewage lagoon 11 Fuel storage 15 Oil well/Gas well  
 3 Watertight sewer lines 6 Seepage pit 9 Feedyard 12 Fertilizer storage 16 Other (specify below)  
 13 Insecticide storage

Direction from well? north How many feet? 260'

FROM	TO	LITHOLOGIC LOG	FROM	TO	PLUGGING INTERVALS
0	2	Top Soil			
2	13	Clay-Brown			
13	25	Fine Sand-Coarse Sand-Med-Pea Gravel			
25	50	Clay-Brown			
50	53	Fine Sand-Brown			
53	57	Fine Sand-Coarse Sand-Med-Pea Gravel			
57	59	Clay-Brown			
59	71	Fine Sand-Brown			
71	77	Fine Sand-Coarse Sand-Med-Pea 1/4x3/8			
77	95	Shale-Grey			

7 CONTRACTOR'S OR LANDOWNER'S CERTIFICATION: This water well was (1) constructed, (2) reconstructed, or (3) plugged under my jurisdiction and was completed on (mo/day/year) 5-26-93 and this record is true to the best of my knowledge and belief. Kansas Water Well Contractor's License No. 182 This Water Well Record was completed on (mo/day/yr) 6-4-93 under the business name of STRADER DRILLING CO., INC. by (signature) Robert Kelley