


1 LOCATION OF WATER WELL: Fraction SW 1/4 NW 1/4 NW 1/4 Section Number 11 Township Number T 11 S Range Number R 15 **E**W

Distance and direction from nearest town or city street address of well if located within city?
2 miles north of Topeka

2 WATER WELL OWNER: W.G. Seedig
RR#, St. Address, Box #: 3815 NW 37th Terrace Board of Agriculture, Division of Water Resources
City, State, ZIP Code: Topeka, KS 66618 Application Number:

3 LOCATE WELL'S LOCATION WITH AN "X" IN SECTION BOX:

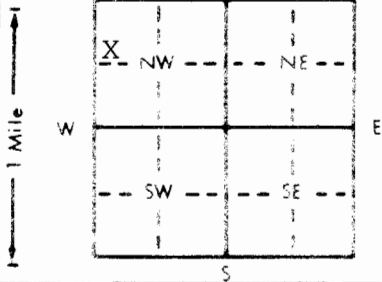

4 DEPTH OF COMPLETED WELL: 80 ft. ELEVATION:
Depth(s) Groundwater Encountered 1. 50 ft. 2. ft. 3. ft.

WELL'S STATIC WATER LEVEL: 40' ft below land surface measured on mo/day/yr 10-04-88
Pump test data: Well water was ft. after hours pumping gpm
Est. Yield 40 gpm: Well water was ft. after hours pumping gpm
Bore Hole Diameter: 12" in. to ft. and in. to ft.
WELL WATER TO BE USED AS:
1 Domestic 3 Feedlot 5 Public water supply 8 Air conditioning 11 injection well
2 Irrigation 4 industrial 6 Oil field water supply 9 Dewatering 12 Other (Specify below)
7 Lawn and garden only 10 Monitoring well
Was a chemical/bacteriological sample submitted to Department? Yes No **X** If yes, mo/day/yr sample was submitted
Water Well Disinfected? Yes **X** No

5 TYPE OF BLANK CASING USED:
1 Steel 3 RMP (SR) 5 Wrought iron 6 Concrete tile CASING JOINTS: Glued **X** Clamped
2 PVC 4 ABS 7 Fiberglass 8 Other (specify below) Welded
Blank casing diameter: 5" in. to 0-65 ft. Dia 5" in. to 76-80 ft. Dia
Casing height above land surface: 24" in. weight 2.82 lbs. ft. Wall thickness or gauge No. 258
TYPE OF SCREEN OR PERFORATION MATERIAL:
1 Steel 3 Stainless steel 5 Fiberglass 7 PVC 10 Asbestos-cement
2 Brass 4 Galvanized steel 6 Concrete tile 8 RMP (SR) 9 ABS 11 Other (specify)
12 None used (open hole)

SCREEN OR PERFORATION OPENINGS ARE:
1 Continuous slot 3 Mill slot 5 Gauzed wrapped 8 Saw cut 11 None (open hole)
2 Louvered shutter 4 Key punched 6 Wire wrapped 9 Drilled holes
7 Torch cut 10 Other (specify)

SCREEN-PERFORATED INTERVALS: From 65 ft. to 76 ft. From ft. to ft.
GRAVEL PACK INTERVALS: From 23 ft. to 80 ft. From ft. to ft.

6 GROUT MATERIAL: 1 Neat cement 2 Cement grout 3 Bentonite 4 Other
Grout intervals: From 3 ft. to 23 ft. From ft. to ft. From ft. to ft.
What is the nearest source of possible contamination:
1 Septic tank 4 Lateral lines 7 Pit privy 10 Livestock pens 14 Abandoned water well
2 Sewer lines 5 Cess pool 8 Sewage lagoon 11 Fuel storage 15 Oil well/Gas well
3 Watertight sewer lines 6 Seepage pit 9 Feedyard 12 Fertilizer storage 16 Other (specify below)
13 Insecticide storage
Direction from well? **S** How many feet? **120**

FROM	TO	LITHOLOGIC LOG	FROM	TO	PLUGGING INTERVALS
0	3	Top Soil			
3	23	Clay-Brown			
23	62	Fine Sand-Brown			
62	75	Fine Sand-Coarse Sand-Med-Pea-Brown			
75	80	Shale-Grey			

NOTE: Permission received from D. Plummer to locate well 17' off property line

7 CONTRACTOR'S OR LANDOWNER'S CERTIFICATION: This water well was (1) constructed, (2) reconstructed, or (3) plugged under my jurisdiction and was completed on (mo/day/year) 10-04-88 and this record is true to the best of my knowledge and belief. Kansas Water Well Contractor's License No. 182 This Water Well Record was completed on (mo/day/yr) 10-18-88 under the business name of Strader Drilling Co., Inc. by (signature) Dale Dobson