


USE TYPEWRITER OR BALL POINT PEN-PRESS FIRMLY, PRINT CLEARLY.

WATER WELL RECORD
KSA 82a-1201-1215

Kansas Department of Health and Environment-Division of Environment
(Water well Contractors)
Topeka, Kansas 66620

1. Location of well: County Shawnee Fraction NE 1/4 SE 1/4 NE 1/4 Section number 21 Township number T 11 S R 15 Range number EW

2. Distance and direction from nearest town or city: S. 24 Hwy
Street address of well location if in city: South of Good Year
3. Owner of well: Meadowood Mobile Estates
R.R. or street:
City, state, zip code: Topeka Kansas

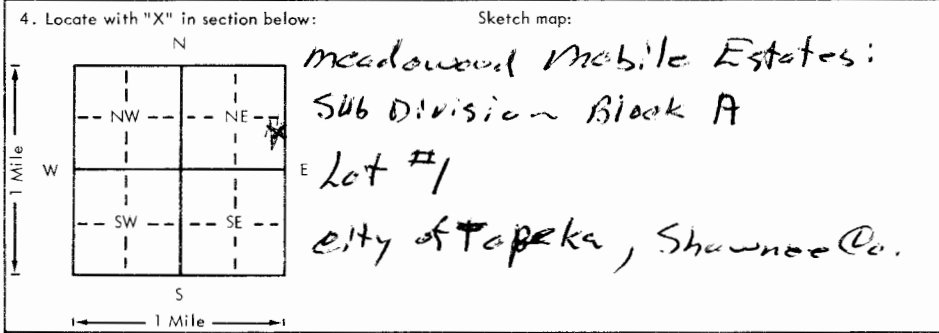

6. Bore hole dia. 8 in. Completion date _____
Well depth 60 ft. 6-30-77
7. Cable tool Rotary Driven Dug
 Hollow rod Jetted Bored Reverse rotary
8. Use: Domestic Public supply Industry
 Irrigation Air conditioning Stock
 Lawn Oil field water Other
9. Casing: Material PVC Height Above or below
Threaded Welded Surface 24 in.
RMP PVC 3/4 Weight 2.74 lbs./ft.
Dia. 0 in. to 60 ft. depth Wall Thickness: inches or
Dia. _____ in. to _____ ft. depth gage No. 1258

5. Type and color of material	From	To
Top Soil Silt	0	4
Brown Clay	4	8
Brown Silt	8	22
Gray Clay	22	27
Brown Coarse Sand	27	30
Brown Med. Gravel	30	36
Gray Clay	36	38
Gray Coarse Sand	38	39
Brown Med Sand	39	60

10. Screen: Manufacturer's name Mit Pump Co -
Type PVC Dia. 5
Slot/gauze .020 Length 10
Set between 50 ft. and 60 ft.
_____ ft. and _____ ft.
Gravel pack? Size range of material 20-60
11. Static water level: _____ mo./day/yr.
25 ft. below land surface Date 6-30-77
12. Pumping level below land surfaces: Air Test
_____ ft. after _____ hrs. pumping _____ g.p.m.
_____ ft. after _____ hrs. pumping _____ g.p.m.
Estimated maximum yield 50 g.p.m.
13. Water sample submitted: _____ mo./day/yr.
Yes No Date _____
14. Well head completion: Top cap
 Pitless adapter 24 inches above grade
15. Well grouted? Yes
With: Neat cement Bentonite Concrete
Depth: From 0 ft. to 10 ft.
16. Nearest source of possible contamination: sewer
ft. 50 Direction W Type Drain
Well disinfected upon completion? Yes No
17. Pump: Not installed
Manufacturer's name _____
Model number _____ HP _____ Volts _____
Length of drop pipe _____ ft. capacity _____ g.p.m.
Type:
 Submersible Turbine
 Jet Reciprocating
 Centrifugal Other

18. Elevation: _____
19. Remarks: _____
Topography:
 Hill
 Slope
 Upland
 Valley

20. Water well contractor's certification:
This well was drilled under my jurisdiction and this report is true to the best of my knowledge and belief.
Staded Dale Co. Inc. 1-82
Business name _____ License No. _____
Address Wartia, KS
Signed Walt Babine Date 7-1-77
Authorized representative

T
R
W
S
E
N
E
1/4
1/4
1/4
1/4