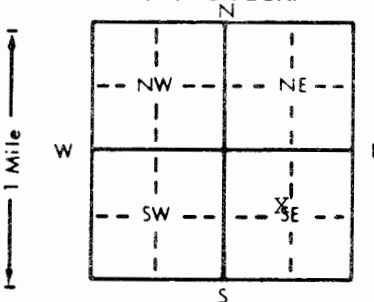


1 LOCATION OF WATER WELL: Fraction NW 1/4 NW 1/4 SE 1/4 Section Number 13 Township Number T 11 S Range Number R 15 **EW**
 County: Shawnee
 Distance and direction from nearest town or city street address of well if located within city?
 Not Available

2 WATER WELL OWNER: Goodyear Tire & Rubber Co.
 RR#, St. Address, Box #: P O Box 1069 Board of Agriculture, Division of Water Resources
 City, State, ZIP Code: Topeka, Kansas 66601 Application Number: 37984

3 LOCATE WELL'S LOCATION WITH AN "X" IN SECTION BOX:

 4 DEPTH OF COMPLETED WELL: 76.0' ft. ELEVATION:
 Depth(s) Groundwater Encountered 1. ft. 2. ft. 3. ft.
 WELL'S STATIC WATER LEVEL: 40.0' ft. below land surface measured on mo/day/yr 10-11-85
 Pump test data: Well water was 65 ft. after 1 hours pumping 1200 gpm
 Est. Yield gpm: Well water was ft. after hours pumping gpm
 Bore Hole Diameter: 32 in. to 76.0' ft., and in. to ft.
 WELL WATER TO BE USED AS:
 5 Public water supply 8 Air conditioning 11 Injection well
 1 Domestic 3 Feedlot 6 Oil field water supply **9 Dewatering** 12 Other (Specify below)
 2 Irrigation 4 Industrial 7 Lawn and garden only 10 Monitoring well
 Was a chemical/bacteriological sample submitted to Department? Yes No **X**; If yes, mo/day/yr sample was sub-
 mitted Water Well Disinfected? Yes **X** No

5 TYPE OF BLANK CASING USED:
 1 Steel 3 RMP (SR) 5 Wrought iron 8 Concrete tile CASING JOINTS: Glued Clamped
 2 PVC 4 ABS 6 Asbestos-Cement 9 Other (specify below) **Welded**
 7 Fiberglass Threaded
 Blank casing diameter: 16 in. to 56.0' ft. Dia in. to ft. Dia in. to ft.
 Casing height above land surface: 12 in., weight . 250 lbs./ft. Wall thickness or gauge No.
 TYPE OF SCREEN OR PERFORATION MATERIAL:
 1 Steel **3 Stainless steel** 5 Fiberglass 8 RMP (SR) 10 Asbestos-cement
 2 Brass 4 Galvanized steel 6 Concrete tile 9 ABS 11 Other (specify)
 12 None used (open hole)
 SCREEN OR PERFORATION OPENINGS ARE:
 1 Continuous slot 3 Mill slot **6 Wire wrapped** 8 Saw cut 11 None (open hole)
 2 Louvered shutter 4 Key punched 7 Torch cut 10 Other (specify)
 SCREEN-PERFORATED INTERVALS: From 56.0' ft. to 76.0' ft. From ft. to ft.
 From ft. to ft. From ft. to ft.
 GRAVEL PACK INTERVALS: From 10.0' ft. to 76.0' ft. From ft. to ft.
 From ft. to ft. From ft. to ft.

6 GROUT MATERIAL: 1 Neat cement **2 Cement grout** **3 Bentonite** 4 Other
 Grout Intervals: From 0 ft. to 10.0' ft. From ft. to ft. From ft. to ft.
 What is the nearest source of possible contamination:
 1 Septic tank 4 Lateral lines 7 Pit privy 10 Livestock pens 14 Abandoned water well
2 Sewer lines 5 Cess pool 8 Sewage lagoon 11 Fuel storage 15 Oil well/Gas well
 3 Watertight sewer lines 6 Seepage pit 9 Feedyard 12 Fertilizer storage 16 Other (specify below)
 13 Insecticide storage
 Direction from well? East How many feet? 475'

FROM	TO	LITHOLOGIC LOG	FROM	TO	PLUGGING INTERVALS
0.0'	30.0'	Soft silt and clay fill	0.0'	10.0'	Concrete
30.0'	50.0'	Fine sand silty material	10.0'	77.0'	Sand Fill
50.0'	58.0'	Fine to medium sand			
58.0'	68.0'	Coarse sand and trace gravel			
68.0'	77.0'	Coarse sand and gravel			

7 CONTRACTOR'S OR LANDOWNER'S CERTIFICATION: This water well was (1) constructed, (2) reconstructed, or **3** plugged under my jurisdiction and was completed on (mo/day/year) 1-16-86 and this record is true to the best of my knowledge and belief. Kansas Water Well Contractor's License No. 4777 This Water Well Record was completed on (mo/day/yr) 8-10-88 under the business name of Scandia, Inc. by (signature) M. J. Osterberg

INSTRUCTIONS: Use typewriter or ball point pen. PLEASE PRESS FIRMLY and PRINT clearly. Please fill in blanks, underline or circle the correct answers. Send top three copies to Kansas Department of Health and Environment, Bureau of Water Protection, Topeka, Kansas 66620-7320. Telephone: 913-296-5514. Send one to WATER WELL OWNER and retain one for your records.