

1] LOCATION OF WATER WELL: Fraction NW 1/4 NW 1/4 SE 1/4 Section Number 13 Township Number T 11 S Range Number R 15

Distance and direction from nearest town or city street address of well if located within city?


Not Available

2] WATER WELL OWNER: GOODYEAR TIRE & RUBBER CO.

RR#, St. Address, Box #: Topeka, Kansas

Board of Agriculture, Division of Water Resources Application Number: 30934

3] LOCATE WELL'S LOCATION WITH AN "X" IN SECTION BOX:

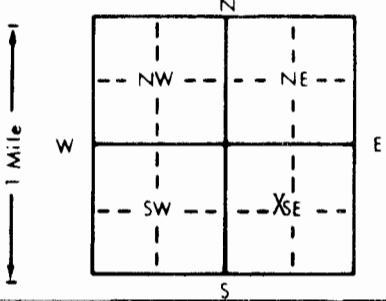

4] DEPTH OF COMPLETED WELL: 76 ft. ELEVATION:

Depth(s) Groundwater Encountered 1 ft. 2 ft. 3 ft. WELL'S STATIC WATER LEVEL 4.0 ft. below land surface measured on mo/day/yr 10-11-85 Pump test data: Well water was 65 ft. after 1 hours pumping 1200 gpm Est. Yield gpm: Well water was ft. after hours pumping gpm Bore Hole Diameter 32 in. to 76 ft. and in. to ft. WELL WATER TO BE USED AS: 5 Public water supply 8 Air conditioning 11 Injection well 1 Domestic 3 Feedlot 6 Oil field water supply 9 Dewatering 12 Other (Specify below) 2 Irrigation 4 Industrial 7 Lawn and garden only 10 Observation well Was a chemical/bacteriological sample submitted to Department? Yes No X If yes, mo/day/yr sample was submitted Water Well Disinfected? Yes No

5] TYPE OF BLANK CASING USED: 1 Steel 2 PVC 3 RMP (SR) 4 ABS 5 Wrought iron 6 Asbestos-Cement 7 Fiberglass 8 Concrete tile 9 Other (specify below) CASING JOINTS: Glued Clamped Welded Threaded

Blank casing diameter 16 in. to 0-56 ft. Dia in. to ft. Dia in. to ft. Casing height above land surface 1 in. weight 250 lbs./ft. Wall thickness or gauge No.

TYPE OF SCREEN OR PERFORATION MATERIAL: 1 Steel 2 Brass 3 Stainless steel 4 Galvanized steel 5 Fiberglass 6 Concrete tile 7 PVC 8 RMP (SR) 9 ABS 10 Asbestos-cement 11 Other (specify) 12 None used (open hole)

SCREEN OR PERFORATION OPENINGS ARE: 1 Continuous slot 2 Louvered shutter 3 Mill slot 4 Key punched 5 Gauzed wrapped 6 Wire wrapped 7 Torch cut 8 Saw cut 9 Drilled holes 10 Other (specify) 11 None (open hole)

SCREEN-PERFORATED INTERVALS: From 56 ft. to 76 ft. GRAVEL PACK INTERVALS: From 10 ft. to 76 ft.

6] GROUT MATERIAL: 1 Neat cement 2 Cement grout 3 Bentonite 4 Other Grout Intervals: From 0 ft. to 10 ft. From ft. to ft. From ft. to ft. From ft. to ft.

What is the nearest source of possible contamination: 1 Septic tank 2 Sewer lines 3 Watertight sewer lines 4 Lateral lines 5 Cess pool 6 Seepage pit 7 Pit privy 8 Sewage lagoon 9 Feedyard 10 Livestock pens 11 Fuel storage 12 Fertilizer storage 13 Insecticide storage 14 Abandoned water well 15 Oil well/Gas well 16 Other (specify below)

Direction from well? How many feet? 475'

Table with columns FROM, TO, LITHOLOGIC LOG. Rows show depth intervals from 0.0' to 77.0' with descriptions like 'Soft silt and clay fill', 'Fine sand silty material', 'Coarse sand and gravel'. Includes 'RECEIVED' stamps dated JUN 8 1988 and JUN 2 1988, and 'K. D. H. E. NORTHEAST DISTRICT' and 'FIELD OFFICE Division of Water Resources Topeka'.

7] CONTRACTOR'S OR LANDOWNER'S CERTIFICATION: This water well was (1) constructed, (2) reconstructed, or (3) plugged under my jurisdiction and was completed on (mo/day/year) 10-11-85 and this record is true to the best of my knowledge and belief. Kansas Water Well Contractor's License No. 429 This Water Well Record was completed on (mo/day/yr) 4-22-88

under the business name of Stang Hydronics by Scandia, Inc. by signature M. D. Swanson