


1 LOCATION OF WATER WELL: Fraction NW 1/4 NW 1/4 SE 1/4 Section Number 13 Township Number T 11 S Range Number R 15 EW

Distance and direction from nearest town or city street address of well if located within city?
Not Available

2 WATER WELL OWNER: Goodyear Tire & Rubber Co.
RR#, St. Address, Box # : PO Box 1069 Board of Agriculture, Division of Water Resources
City, State, ZIP Code : Topeka, Kansas 66601 Application Number: 37984

3 LOCATE WELL'S LOCATION WITH AN "X" IN SECTION BOX:
4 DEPTH OF COMPLETED WELL: 74.7' ft. ELEVATION:
Depth(s) Groundwater Encountered 1. ft. 2. ft. 3. ft.
WELL'S STATIC WATER LEVEL . . . 40.0' ft. below land surface measured on mo/day/yr 10/12/85
Pump test data: Well water was . . . 65.0' ft. after . . . 1 hours pumping . . . 1200 gpm
Est. Yield gpm: Well water was ft. after hours pumping gpm
Bore Hole Diameter . . . 32 . . . in. to . . . 74.0' ft., and in. to ft.
WELL WATER TO BE USED AS: 5 Public water supply 8 Air conditioning 11 Injection well
1 Domestic 3 Feedlot 6 Oil field water supply 9 Dewatering 12 Other (Specify below)
2 Irrigation 4 Industrial 7 Lawn and garden only 10 Monitoring well
Was a chemical/bacteriological sample submitted to Department? Yes No X If yes, mo/day/yr sample was sub-
mitted Water Well Disinfected? Yes X No

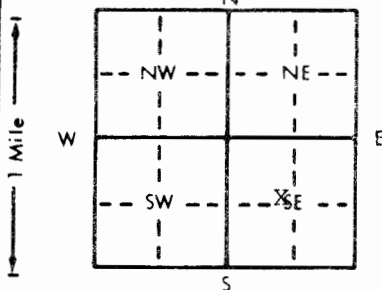

5 TYPE OF BLANK CASING USED: 5 Wrought iron 8 Concrete tile CASING JOINTS: Glued Clamped
1 Steel 3 RMP (SR) 6 Asbestos-Cement 9 Other (specify below) Welded
2 PVC 4 ABS 7 Fiberglass Threaded

Blank casing diameter . . . 16 . . . in. to . . . 54.0' ft., Dia in. to ft., Dia in. to ft.
Casing height above land surface . . . 12 . . . in., weight 0.25 lbs./ft. Wall thickness or gauge No.

TYPE OF SCREEN OR PERFORATION MATERIAL: 7 PVC 10 Asbestos-cement
1 Steel 3 Stainless steel 5 Fiberglass 8 RMP (SR) 11 Other (specify)
2 Brass 4 Galvanized steel 6 Concrete tile 9 ABS 12 None used (open hole)

SCREEN OR PERFORATION OPENINGS ARE: 5 Gauzed wrapped 8 Saw cut 11 None (open hole)
1 Continuous slot 3 Mill slot 6 Wire wrapped 9 Drilled holes
2 Louvered shutter 4 Key punched 7 Torch cut 10 Other (specify)

SCREEN-PERFORATED INTERVALS: From . . . 54.0' ft. to . . . 74.0' ft., From ft. to ft.
From ft. to ft., From ft. to ft.

GRAVEL PACK INTERVALS: From . . . 10.0' ft. to . . . 74.0' ft., From ft. to ft.
From ft. to ft., From ft. to ft.

6 GROUT MATERIAL: 1 Neat cement 2 Cement grout 3 Bentonite 4 Other
Grout Intervals: From . . . 0 ft. to . . . 10.0' ft., From ft. to ft., From ft. to ft.

What is the nearest source of possible contamination: 10 Livestock pens 14 Abandoned water well
1 Septic tank 4 Lateral lines 7 Pit privy 11 Fuel storage 15 Oil well/Gas well
2 Sewer lines 5 Cess pool 8 Sewage lagoon 12 Fertilizer storage 16 Other (specify below)
3 Watertight sewer lines 6 Seepage pit 9 Feedyard 13 Insecticide storage

Direction from well? East How many feet? 475'

FROM	TO	LITHOLOGIC LOG	FROM	TO	PLUGGING INTERVALS
0.0'	31.0'	Soft material clay and fill	0.0'	10.0'	Concrete
31.0'	53.0'	Fine sandy material	10.0'	74.0'	Sand fill
53.0'	60.0'	Medium sand			
60.0'	69.0'	Coarse sand "good"			
69.0'	74.0'	Coarse sand and gravel			

7 CONTRACTOR'S OR LANDOWNER'S CERTIFICATION: This water well was (1) constructed, (2) reconstructed, or (3) plugged under my jurisdiction and was completed on (mo/day/year) . . . 1-16-86 and this record is true to the best of my knowledge and belief. Kansas Water Well Contractor's License No. 429 This Water Well Record was completed on (mo/day/yr) . . . 8-10-88 under the business name of Scandia, Inc. by (signature) M. L. Gordenberg