


1] LOCATION OF WATER WELL: Fraction NW 1/4 NW 1/4 SE 1/4 Section Number 13 Township Number T 11 S Range Number R 15 **KW**  
 County: Shawnee

Distance and direction from nearest town or city street address of well if located within city?

Not Available

2] WATER WELL OWNER: Goodyear tire & Rubber Co.  
 RR#, St. Address, Box # :  
 City, State, ZIP Code : Topeka, Kansas  
 Board of Agriculture, Division of Water Resources  
 Application Number: 37984

3] LOCATE WELL'S LOCATION WITH AN "X" IN SECTION BOX:

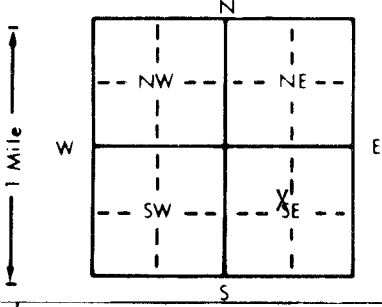

4] DEPTH OF COMPLETED WELL: 74'7" ft. ELEVATION:  
 Depth(s) Groundwater Encountered 1. ft. 2. ft. 3. ft.  
 WELL'S STATIC WATER LEVEL: 40 ft. below land surface measured on mo/day/yr 10-14-85  
 Pump test data: Well water was 65' ft. after 1 hours pumping 1200 gpm  
 Est. Yield gpm: Well water was ft. after hours pumping gpm  
 Bore Hole Diameter: 32 in. to 74' ft. and in. to ft.  
 WELL WATER TO BE USED AS:  
 1 Domestic 3 Feedlot 5 Public water supply 8 Air conditioning 11 Injection well  
 2 Irrigation 4 Industrial 6 Oil field water supply 9 Dewatering 12 Other (Specify below)  
 7 Lawn and garden only 10 Observation well  
 Was a chemical/bacteriological sample submitted to Department? Yes No  If yes, mo/day/yr sample was submitted  
 Water Well Disinfected? Yes No

5] TYPE OF BLANK CASING USED:  
 1 Steel 3 RMP (SR) 5 Wrought iron 8 Concrete tile CASING JOINTS: Glued Clamped  
 2 PVC 4 ABS 6 Asbestos-Cement 9 Other (specify below) Welded  
 7 Fiberglass Threaded  
 Blank casing diameter: 16" in. to 54'-7" ft. Dia. in. to ft. Dia. in. to ft.  
 Casing height above land surface: 1' in. weight .0250 lbs. ft. Wall thickness or gauge No.  
 TYPE OF SCREEN OR PERFORATION MATERIAL:  
 1 Steel 3 Stainless steel 5 Fiberglass 8 RMP (SR) 10 Asbestos-cement  
 2 Brass 4 Galvanized steel 6 Concrete tile 9 ABS 11 Other (specify)  
 12 None used (open hole)  
 SCREEN OR PERFORATION OPENINGS ARE:  
 1 Continuous slot 3 Mill slot 5 Gauzed wrapped 8 Saw cut 11 None (open hole)  
 2 Louvered shutter 4 Key punched 6 Wire wrapped 9 Drilled holes  
 7 Torch cut 10 Other (specify)  
 SCREEN-PERFORATED INTERVALS: From 54'-7" ft. to 74'-7" ft. From ft. to ft.  
 GRAVEL PACK INTERVALS: From 10' ft. to 74'-7" ft. From ft. to ft.

6] GROUT MATERIAL: 1 Neat cement 2 Cement grout 3 Bentonite 4 Other  
 Grout Intervals: From 0' ft. to 10' ft. From ft. to ft. From ft. to ft.  
 What is the nearest source of possible contamination:  
 1 Septic tank 4 Lateral lines 7 Pit privy 10 Livestock pens 14 Abandoned water well  
 2 Sewer lines 5 Cess pool 8 Sewage lagoon 11 Fuel storage 15 Oil well/Gas well  
 3 Watertight sewer lines 6 Seepage pit 9 Feedyard 12 Fertilizer storage 16 Other (specify below)  
 13 Insecticide storage  
 Direction from well? How many feet? 475

FROM	TO	LITHOLOGIC LOG	FROM	TO	LITHOLOGIC LOG
0.0'	30.0'	Fill			
30.0'	50.0'	Fine sand			
50.0'	59.0'	Medium to coarse sand & trace gravel			Medium to fine "clean sand"
59.0'	67.0'	Medium to coarse sand & trace gravel			
67.0'	74.6'	Coarse sand and gravel			

RECEIVED  
 JUN 8 1988

RECEIVED  
 JUN 2 1988

K. D. H. E.  
 NORTHEAST DISTRICT

FIELD OFFICE  
 Division of Water Resources  
 Topeka

7] CONTRACTOR'S OR LANDOWNER'S CERTIFICATION: This water well was (1) constructed, (2) reconstructed, or (3) plugged under my jurisdiction and was completed on (mo/day/year) 10-14-85 and this record is true to the best of my knowledge and belief. Kansas Water Well Contractor's License No. 429 This Water Well Record was completed on (mo/day/yr) 4-22-88 under the business name of Stang Hydronics by Scandia, Inc. by (signature) *M. Scandia*