

## WATER WELL RECORD Form WWC-5 KSA 82a-1212

1 LOCATION OF WATER WELL:  
County: Shawnee

Fraction

NW 1/4 NW 1/4 SE 1/4

Section Number

13

Township Number

T

11

S

Range Number

R 15

EW

Distance and direction from nearest town or city street address of well if located within city?

Not Available

2 WATER WELL OWNER: Goodyear Tire &amp; Rubber Co.


RR#, St. Address, Box #: P O Box 1069

Board of Agriculture, Division of Water Resources

City, State, ZIP Code: Topeka, Kansas 66601

Application Number: 37984

3 LOCATE WELL'S LOCATION WITH AN "X" IN SECTION BOX:

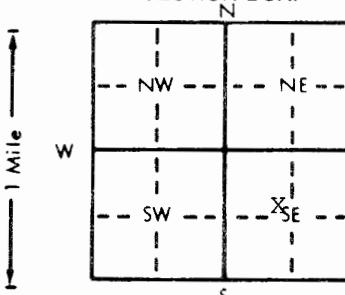

4 DEPTH OF COMPLETED WELL: 83.0' ft. ELEVATION:

Depth(s) Groundwater Encountered 1. ft. 2. ft. 3. ft.

WELL'S STATIC WATER LEVEL ft. below land surface measured on mo/day/yr

Pump test data: Well water was ft. after hours pumping gpm

Est. Yield gpm: Well water was ft. after hours pumping gpm

Bore Hole Diameter 22 in. to 83.0' ft., and in. to ft.

WELL WATER TO BE USED AS: 5 Public water supply 8 Air conditioning 11 Injection well

1 Domestic 3 Feedlot 6 Oil field water supply 9 Dewatering 12 Other (Specify below)

2 Irrigation 4 Industrial 7 Lawn and garden only 10 Monitoring well

Was a chemical/bacteriological sample submitted to Department? Yes. No. X. If yes, mo/day/yr sample was submitted Water Well Disinfected? Yes X No

5 TYPE OF BLANK CASING USED:

1 Steel 3 RMP (SR)  
 2 PVC 4 ABS

5 Wrought iron 8 Concrete tile  
 6 Asbestos-Cement 9 Other (specify below)

CASING JOINTS: Glued Clamped  
 Welded Threaded

Blank casing diameter 12 in. to 65.0' ft., Dia. in. to ft., Dia. in. to ft.

Casing height above land surface 24 in., weight lbs./ft. Wall thickness or gauge No.

TYPE OF SCREEN OR PERFORATION MATERIAL:

1 Steel 3 Stainless steel  
 2 Brass 4 Galvanized steel

5 Fiberglass 7 PVC  
 6 Concrete tile 9 ABS

10 Asbestos-cement  
 11 Other (specify)  
 12 None used (open hole)

SCREEN OR PERFORATION OPENINGS ARE:

1 Continuous slot 3 Mill slot  
 2 Louvered shutter 4 Key punched

5 Gauzed wrapped 8 Saw cut  
 6 Wire wrapped 9 Drilled holes  
 7 Torch cut 10 Other (specify)

11 None (open hole)

SCREEN-PERFORATED INTERVALS: From. 65.0' ft. to 83.0' ft., From. ft. to ft., From. ft. to ft.

From. ft. to ft., From. ft. to ft., From. ft. to ft.

GRAVEL PACK INTERVALS: From. 38.0' ft. to 83.0' ft., From. ft. to ft., From. ft. to ft.

From. ft. to ft., From. ft. to ft., From. ft. to ft.

6 GROUT MATERIAL: 1 Neat cement 2 Cement grout 3 Bentonite 4 Other

Grout Intervals: From. 60.0' ft. to 65.0' ft., From. ft. to ft., From. ft. to ft.

What is the nearest source of possible contamination:

1 Septic tank 4 Lateral lines  
 2 Sewer lines 5 Cess pool  
 3 Watertight sewer lines 6 Seepage pit

7 Pit privy 8 Sewage lagoon  
 9 Feedyard

10 Livestock pens 14 Abandoned water well  
 11 Fuel storage 15 Oil well/Gas well  
 12 Fertilizer storage 16 Other (specify below)  
 13 Insecticide storage

Direction from well? East How many feet? 475'

FROM	TO	LITHOLOGIC LOG	FROM	TO	PLUGGING INTERVALS
0.0'	3.0'	Brown silty clay, fill	0.0'	10.0'	Concrete
3.0'	10.0'	Dark gray clay, stiff	10.0'	83.3'	Sand fill
10.0'	38.0'	Brown silty clay, very stiff			
38.0'	82.3'	Gray brown coarse to med. sand w/ fine sand, gravel & boulders			
82.3'	83.3'	Green gray & tan weathered shale			
		TOTAL DEPTH			

7 CONTRACTOR'S OR LANDOWNER'S CERTIFICATION: This water well was (1) constructed, (2) reconstructed, or (3) plugged under my jurisdiction and was completed on (mo/day/year) 1-16-86 and this record is true to the best of my knowledge and belief. Kansas

Water Well Contractor's License No 4329 This Water Well Record was completed on (mo/day/yr) 8/10/88 under the business name of Scandia, Inc. by (signature) M. J. Bostenberg