


1 LOCATION OF WATER WELL: Fraction SE 1/4 SE 1/4 SW 1/4 Section Number 13 Township Number T 11 S Range Number R 15E (EW)

Distance and direction from nearest town or city street address of well if located within city?
 1/4 north of Topeka

2 WATER WELL OWNER: H.P.S. Construction Company
 RR#, St. Address, Box #: P.O. Box 8181 Board of Agriculture, Division of Water Resources
 City, State, ZIP Code: Topeka, KS 66608 Application Number:

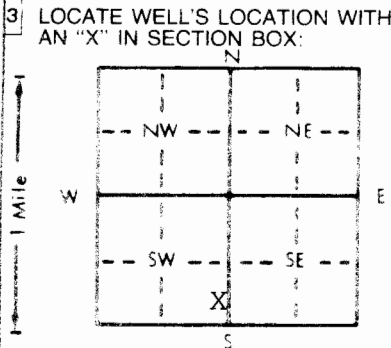

4 DEPTH OF COMPLETED WELL: 53 ft. ELEVATION:
 Depth(s) Groundwater Encountered: 1. 40 ft. 2. ft. 3. ft.
 WELL'S STATIC WATER LEVEL: 33' ft. below land surface measured on mo/day/yr 2-17-89
 Pump test data: Well water was ft. after hours pumping gpm
 Est. Yield: 40 gpm Well water was ft. after hours pumping gpm
 Bore Hole Diameter: 12" in. to ft. and in. to ft.
 WELL WATER TO BE USED AS:
 1 Domestic 2 Irrigation 3 Feedlot 4 Industrial 5 Public water supply 6 Oil field water supply 7 Lawn and garden only 8 Air conditioning 9 Dewatering 10 Monitoring well 11 Injection well 12 Other (Specify below)
 Was a chemical/bacteriological sample submitted to Department? Yes No X If yes, mo/day/yr sample was submitted
 Water Well Disinfected? Yes X No

5 TYPE OF BLANK CASING USED:
 1 Steel 2 PVC 3 RMP (SR) 4 ABS 5 Wrought iron 6 Asbestos-Cement 7 Fiberglass 8 Concrete tile 9 Other (specify below)
 Blank casing diameter: 5" in. to 0-43 ft. Dia. in. to ft. Dia. in. to ft.
 Casing height above land surface: 24" in. weight: 2.82 lbs./ft. Wall thickness or gauge No. .258
 TYPE OF SCREEN OR PERFORATION MATERIAL:
 1 Steel 2 Brass 3 Stainless steel 4 Galvanized steel 5 Fiberglass 6 Concrete tile 7 PVC 8 RMP (SR) 9 ABS 10 Asbestos-cement 11 Other (specify) 12 None used (open hole)
 SCREEN OR PERFORATION OPENINGS ARE:
 1 Continuous slot 2 Louvered shutter 3 Mill slot 4 Key punched 5 Gauzed wrapped 6 Wire wrapped 7 Torch cut 8 Saw cut 9 Drilled holes 11 None (open hole)
 SCREEN-PERFORATED INTERVALS: From 43 ft. to 53 ft. From ft. to ft. From ft. to ft. From ft. to ft.
 GRAVEL PACK INTERVALS: From 24 ft. to 53 ft. From ft. to ft. From ft. to ft. From ft. to ft.

6 GROUT MATERIAL: 1 Neat cement 2 Cement grout 3 Bentonite 4 Other
 Grout Intervals: From 4 ft. to 24 ft. From ft. to ft. From ft. to ft. From ft. to ft.
 What is the nearest source of possible contamination:
 1 Septic tank 2 Sewer lines 3 Watertight sewer lines 4 Lateral lines 5 Cess pool 6 Seepage pit 7 Pit privy 8 Sewage lagoon 9 Feedyard 10 Livestock pens 11 Fuel storage 12 Fertilizer storage 13 Insecticide storage 14 Abandoned water well 15 Oil well/Gas well 16 Other (specify below)
 Direction from well? SW How many feet? 210

| FROM | TO | LITHOLOGIC LOG | FROM | TO | PLUGGING INTERVALS |
|------|----|--|------|----|--------------------|
| 0 | 30 | Clay-Brown | | | |
| 30 | 53 | Fine Sand-Coarse Sand-Med-Pea Gravel-Brown | | | |
| 53- | | Green | | | |

7 CONTRACTOR'S OR LANDOWNER'S CERTIFICATION: This water well was (1) constructed, (2) reconstructed, or (3) plugged under my jurisdiction and was completed on (mo/day/year) 2-17-89 and this record is true to the best of my knowledge and belief. Kansas Water Well Contractor's License No. 182 This Water Well Record was completed on (mo/day/yr) 4-21-89 under the business name of STRADER DRILLING CO., INC. by (signature) Dale Strader