


LOCATION OF WATER WELL: County: SHAWNEE Fraction: NE 1/4 SW 1/4 NW 1/4 Section Number: 13 Township Number: T 11S S Range Number: R 15E E/W

Distance and direction from nearest town or city street address of well if located within city? 2643 NW Old Indianola Rd.

WATER WELL OWNER: Ken Cochran Estate 4845 NW 25th Topeka, KS 66618 Board of Agriculture, Division of Water Resources Application Number:

LOCATE WELL'S LOCATION WITH AN "X" IN SECTION BOX:

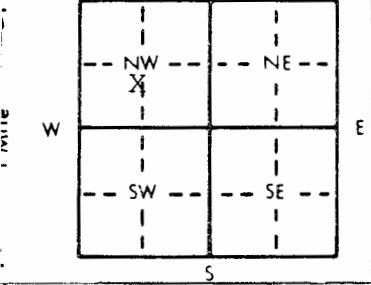

DEPTH OF COMPLETED WELL: 55 ft. ELEVATION: 28' ft. below land surface measured on mo/day/yr 4-15-94. Pump test data: Well water was ... Est. Yield 50 gpm; Well water was ... Bore Hole Diameter 12" in. to ... WELL WATER TO BE USED AS: 5 Public water supply, 8 Air conditioning, 11 Injection well, 1 Domestic, 3 Feedlot, 6 Oil field water supply, 9 Dewatering, 12 Other (Specify below), 2 Irrigation, 4 Industrial, 7 Lawn and garden only, 10 Monitoring well. Was a chemical/bacteriological sample submitted to Department? Yes No X; If yes, mo/day/yr sample was submitted. Water Well Disinfected? Yes X No

TYPE OF BLANK CASING USED: 1 Steel, 3 RMP (SR), 2 PVC, 4 ABS, 5 Wrought iron, 6 Asbestos-Cement, 7 Fiberglass, 8 Concrete tile, 9 Other (specify below), CASING JOINTS: Glued X Clamped, Welded, Threaded.

Blank casing diameter 5" in. to 0-47 ft., Dia. Casing height above land surface 24" in., weight 2.82 lbs./ft. Wall thickness or gauge No. 258

TYPE OF SCREEN OR PERFORATION MATERIAL: 1 Steel, 3 Stainless steel, 2 Brass, 4 Galvanized steel, 5 Fiberglass, 6 Concrete tile, 7 PVC, 8 RMP (SR), 9 ABS, 10 Asbestos-cement, 11 Other (specify), 12 None used (open hole)

SCREEN OR PERFORATION OPENINGS ARE: 1 Continuous slot, 2 Louvered shutter, 3 Mill slot, 4 Key punched, 5 Gauzed wrapped, 6 Wire wrapped, 7 Torch cut, 8 Saw cut, 9 Drilled holes, 10 Other (specify), 11 None (open hole)

SCREEN-PERFORATED INTERVALS: From 47 ft. to 55 ft. GRAVEL PACK INTERVALS: From 24 ft. to 55 ft.

GROUT MATERIAL: 1 Neat cement, 2 Cement grout, 3 Bentonite, 4 Other. Grout intervals: From 4 ft. to 24 ft.

What is the nearest source of possible contamination: 1 Septic tank, 2 Sewer lines, 3 Watertight sewer lines, 4 Lateral lines, 5 Cess pool, 6 Seepage pit, 7 Pit privy, 8 Sewage lagoon, 9 Feedyard, 10 Livestock pens, 11 Fuel storage, 12 Fertilizer storage, 13 Insecticide storage, 14 Abandoned water well, 15 Oil well/Gas well, 16 Other (specify below). Direction from well? south How many feet? 100'

Table with columns: FROM, TO, LITHOLOGIC LOG, FROM, TO, PLUGGING INTERVALS. Rows include: 0-3 Top Soil, 3-29 Clay-Brown, 29-35 Clay-Grey, 35-39 Fine Sand-Blue-Grey, 39-55 Fine-Coarse Sand-Brown.

CONTRACTOR'S OR LANDOWNER'S CERTIFICATION: This water well was (1) constructed, (2) reconstructed, or (3) plugged under my jurisdiction and was completed on (mo/day/year) 4-15-94 and this record is true to the best of my knowledge and belief. Kansas Water Well Contractor's License No. 182 This Water Well Record was completed on (mo/day/yr) 6-17-94 under the business name of STRADER DRILLING CO., INC. by (signature) Dale Strader