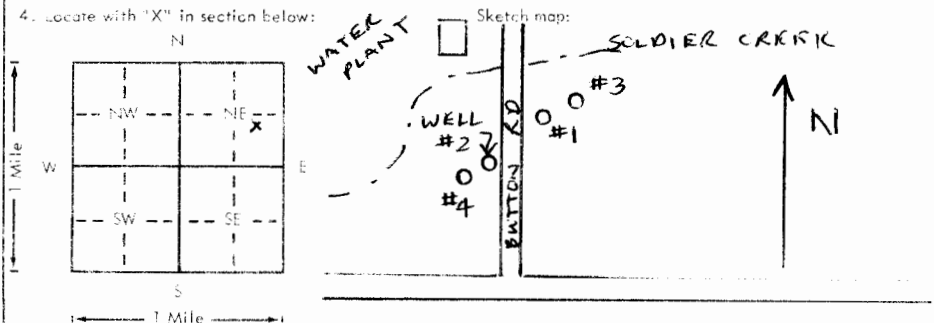


USE TYPEWRITER OR BALL POINT PEN-PRESS FIRMLY, PRINT CLEARLY.

WATER WELL RECORD
KSA 62a-1201-1215

Kansas Department of Health and Environment-Division of Environment
(Water well Contractors)
Topeka, Kansas 66620

1. Location of well: County <u>SHAWNEE</u> Fraction <u>NE 1/4 SE 1/4 NE 1/4</u> Section number <u>14</u> Township number <u>T 11 S R 15 E</u> Range number <u>15</u>	
2. Distance and direction from nearest town or city: <u>1 mi N.W. TOPEKA</u> 3. Owner of well: <u>R.W.D. No. 4</u> Street address of well location if in city: R.R. or street: <u>N.W. BUTTON, RD.</u> City, state, zip code: <u>TOPEKA, KS?</u>	
4. Locate with "X" in section below: 	
5. Type and color of material	
	From To
<u>PLUGGING MATLS</u>	
<u>NATURAL BACKFILL</u>	<u>0</u> <u>3'</u>
<u>NEAT CEMENT</u>	<u>3'</u> <u>34'</u>
<u>DISENFECTED GRAVEL SAND MIX</u>	<u>34'</u> <u>60'</u>
6. Bore hole dia. _____ in. Completion date <u>5/9/80</u> Well depth <u>60</u> ft.	
7. Cable tool _____ Rotary _____ Driven _____ Dug _____ Hollow rod _____ Jetted _____ Bored _____ Reverse rotary _____	
8. Use: _____ Domestic <input checked="" type="checkbox"/> Public supply _____ Industry _____ Irrigation _____ Air conditioning _____ Stock _____ Lawn _____ Oil field water _____ Other _____	
9. Casing: Material <u>STEEL</u> Height: <u>Above</u> or below Threaded _____ Welded <input checked="" type="checkbox"/> Surface <u>12"</u> in. RMP _____ PVC _____ Weight <u>UNKNOWN</u> lbs./ft. Dia. <u>10</u> in. to <u>45</u> ft. depth Wall Thickness: inches or Dia. _____ in. to _____ ft. depth Gauge No. <u>UNKNOWN</u>	
10. Screen: Manufacturer's name <u>UNKNOWN</u> Type <u>UNKNOWN</u> Dia. <u>10"</u> Slot/gauze <u>UNKNOWN</u> Length: <u>15'</u> Set between <u>45</u> ft. and <u>60</u> ft. Gravel pack? <u>YES</u> Size range of material <u>UNKNOWN</u>	
11. Static water level: _____ ft. below land surface Date <u>5/9/80</u> ^{mo./day/yr.}	
12. Pumping level below land surfaces: _____ ft. after _____ hrs. pumping _____ g.p.m. _____ ft. after _____ hrs. pumping _____ g.p.m. Estimated maximum yield <u>UNKNOWN</u> g.p.m.	
13. Water sample submitted: <u>NOT APPLICABLE</u> ^{mo./day/yr.} Yes _____ No _____ Date _____	
14. Well head completion: <input checked="" type="checkbox"/> Pitless adapter _____ inches above grade	
15. Well grouted? <u>YES</u> With: <input checked="" type="checkbox"/> Neat cement _____ Bentonite _____ Concrete _____ Depth: From <u>0</u> ft. to <u>30</u> ft.	
16. Nearest source of possible contamination: ft. <u>30</u> Direction <u>EAST</u> Type <u>ROAD</u> Well disinfected upon completion? <input checked="" type="checkbox"/> Yes _____ No _____	
17. Pump: <u>REMOVED</u> _____ Not installed Manufacturer's name <u>?</u> Model number _____ HP _____ Volts _____ Length of drop pipe _____ ft. capacity _____ g.p.m. Type: <input checked="" type="checkbox"/> Submersible _____ Turbine _____ _____ Jet _____ Reciprocating _____ _____ Centrifugal _____ Other _____	
(Use a second sheet if needed)	
18. Elevation: <u>885</u> Topography: _____ Hill _____ Slope _____ Upland _____ <input checked="" type="checkbox"/> Valley	19. Remarks: <u>PLUGGING REPORT</u> <u>WELL #2 ABANDONED</u>
20. Water well contractor's certification: This well was drilled under my jurisdiction and this report is true to the best of my knowledge and belief. <u>Layne Western Co.</u> <u>102</u> Business name License No. Address <u>1910 W. 39 KC, Mo.</u> Signed <u>Don D. Higgins</u> Date <u>5/20/80</u> Authorized representative	