4 /

✓ change el jd 12

USE TYPEWRITER OR BALL POINT PEN-PRESS FIRMLY, PRINT CLEARLY.

WATER WELL RECORD
KSA 82a-1201-1215

BCD

Kansas Department of Health and Environment-Division of Environment
(Water well Contractors)
Topeka, Kansas 66620

1. Location of well:	County	Fraction	Section number	Township number	Range number
	m Shawnee	SE 1/4 SW 1/4 NW 1/4	15	T 11S S	R 15E E/W

2. Distance and direction from nearest town or city: 1½ miles West of Topeka, Ks. & Brickyard Rd. on N.W. 25th St.
Street address of well location if in city:

3. Owner of well: Don C. Hoss
R.R. or street: 2729 Ashworth Place
City, state, zip code: Topeka, Kansas 66614

4. Locate with "X" in section below:

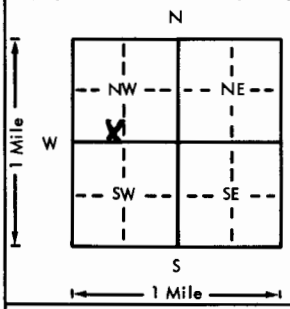

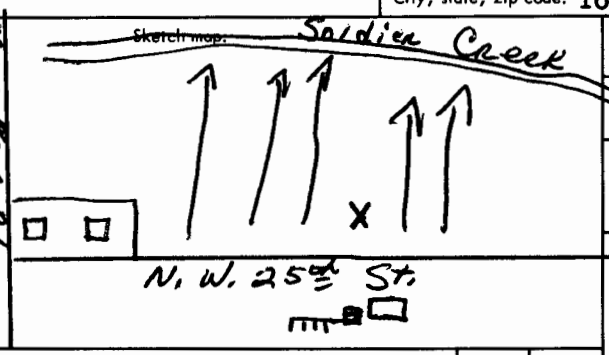

6. Bore hole dia. 30 in. Completion date 6-18-77
Well depth 56 ft.

7. __ Cable tool __ Rotary __ Driven __ Dug
__ Hollow rod __ Jetted __ Bored X Reverse rotary

8. Use: __ Domestic __ Public supply __ Industry
X Irrigation __ Air conditioning __ Stock
__ Lawn __ Oil field water __ Other

9. Casing: Material steel Height: Above or below
Threaded ___ Welded X Surface 12 in.
RMP ___ PVC ___ Weight ___ lbs./ft.
Dia. 16 in. to 36 ft. depth Wall Thickness: inches or
Dia. ___ in. to ___ ft. depth gage No. .219 w.t.

5. Type and color of material	From	To
Black top soil	0	3
Brown silty sand	3	29
Gray clay	29	35
Small brown gravel	35	36
Med. brown gravel	36	52
Med. gray gravel	52	56
Hard gray clay-stopped.	56	
(Use a second sheet if needed)		

10. Screen: Manufacturer's name Free Flo
W. A. Brown Enterprises
Type steel Dia. 16"
Slot/gauze 1/4x4 Length 20'
Set between 36 ft. and 56 ft.
___ ft. and ___ ft.
Gravel pack? yes Size range of material 1/8-1/4"

11. Static water level: mo./day/yr.
31½ ft. below land surface Date 6-18-77

12. Pumping level below land surfaces:
35 ft. after 1 hrs. pumping 700 g.p.m.
40 ft. after 3 hrs. pumping 850 g.p.m.
Estimated maximum yield 1000 g.p.m.

13. Water sample submitted: mo./day/yr.
__ Yes X No Date ___

14. Well head completion:
__ Pitless adapter ___ Inches above grade

15. Well grouted? yes
With: __ Neat cement __ Bentonite X Cancrete
Depth: From 0 ft. to 10 ft.

16. Nearest source of possible contamination:
ft. 200 Direction south Type laterals
Well disinfected upon completion? ___ Yes X No

17. Pump: X Not installed
Manufacturer's name ___
Model number ___ HP ___ Volts ___
Length of drop pipe ___ ft. capacity ___ g.p.m.
Type:
__ Submersible __ Turbine
__ Jet __ Reciprocating
__ Centrifugal __ Other

T 11 R 15 E/W Sec 15 SE 1/4 SW 1/4 NW 1/4

18. Elevation: 892
Topography: 896
__ Hill
__ Slope
__ Upland
X Valley

19. Remarks: We do not install pumps.

20. Water well contractor's certification:
This well was drilled under my jurisdiction and this report is true to the best of my knowledge and belief.
Hoobler Drilling Co. 323
Business name License No.
Address St. Marys, Ks. 66536
Signed Dean Hoobler Date 7-13-77
Authorized representative

Forward the white, blue and pink copies to the Department of Health and Environment

Form WWC-5

BR < 836 ▽ = 860

jd

MI-1023