297

Topeka
Chore

6/18/81

Yd

USE TYPEWRITER OR BALL POINT PEN-PRESS FIRMLY, PRINT CLEARLY.

WATER WELL RECORD
KSA 82a-1201-1215

Kansas Department of Health and Environment-Division of Environment
(Water well Contractors)
Topeka, Kansas 66620

SE BCD

1. Location of well:	County	Fraction	Section number	Township number	Range number
	SHAWNEE	1/4 SW 1/4 NW 1/4	15	T 11 S	R 15 E

2. Distance and direction from nearest town or city: NW TOPEKA
Street address of well location if in city: OLD Hy 24

3. Owner of well: MR. R. SPURGEON
R.R. or street: RT-6
City, state, zip code: TOPEKA, KAN. 66618

4. Locate with "X" in section below:

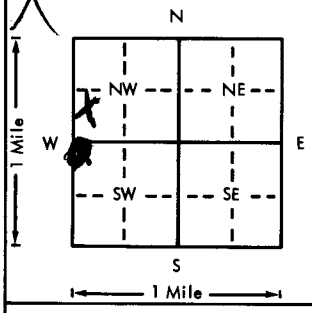

Sketch map:

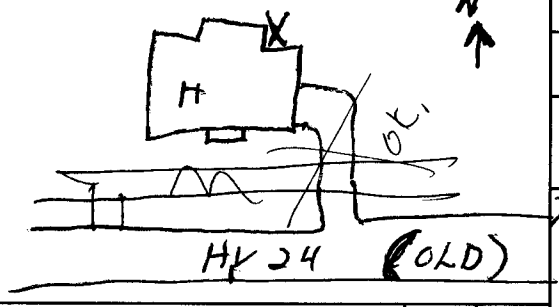

6. Bore hole dia. 8 in. Completion date 3-11-77
Well depth 55 ft.

7. ✓ Cable tool __ Rotary __ Driven __ Dug
__ Hollow rod __ Jetted __ Bored __ Reverse rotary

8. Use: ✓ Domestic __ Public supply __ Industry
__ Irrigation __ Air conditioning __ Stock
__ Lawn __ Oil field water __ Other

9. Casing: Material ____ Height: Above or below
Threaded ____ Welded ____ Surface ____ in.
RMP ✓ PVC ____ Weight ____ lbs./ft.
Dia. 5 in. to 55 ft. depth Wall Thickness: inches or
Dia. ____ in. to ____ ft. depth gage No. 200

10. Screen: Manufacturer's name SUNFLOWER
Type ____ Dia. ____
Slot/gauze ✓ Length 5'
Set between BOTTOM ft. and ____ ft.
____ ft. and ____ ft.
Gravel pack? ✓ Size range of material 1/8"

11. Static water level: mo./day/yr.
32 ft. below land surface Date 3-11-77

12. Pumping level below land surfaces:
32 ft. after 2 hrs. pumping 16 g.p.m.
____ ft. after ____ hrs. pumping ____ g.p.m.
Estimated maximum yield 18 g.p.m.

13. Water sample submitted: mo./day/yr.
__ Yes ✓ No Date ____

14. Well head completion:
✓ Pitless adapter 16 Inches above grade

15. Well grouted? ✓
With: ✓ Neat cement ____ Bentonite ____ Concrete
Depth: From 35 ft. to 13 ft.

16. Nearest source of possible contamination:
ft. 75' Direction SE Type SEPTIC
Well disinfected upon completion? ____ Yes ____ No

17. Pump: ____ Not installed
Manufacturer's name GOULDS
Model number UEH HP 1/2 Volts 230
Length of drop pipe 46 ft. capacity 7 g.p.m.
Type:
✓ Submersible ____ Turbine
____ Jet ____ Reciprocating
____ Centrifugal ____ Other

5. Type and color of material

	From	To
Top Soil	0	8
Silt + Brow Earth	8	15
Sandy Silt	15	25
Sand	25	30
Hard pan	30	32
Sand + Gravel	32	41
Black Mud	41	43
Sand + Gravel	43	55

(Use a second sheet if needed)

18. Elevation: ~890 ft
Topography:
____ Hill
____ Slope
____ Upland
____ Valley

19. Remarks:

20. Water well contractor's certification:
This well was drilled under my jurisdiction and this report is true to the best of my knowledge and belief.
H. L. POTTIT 333
Business name License No.
Address 905 N MICHIGAN
Signed H. L. Pottit Date 3-20-77
Authorized representative

T 11 R 15 E W Sec 15 1/4 1/4 1/4 NWSWW

Forward the white, blue and pink copies to the Department of Health and Environment

Form WWC-5

MI-1023